


T40S. R19E. WM.

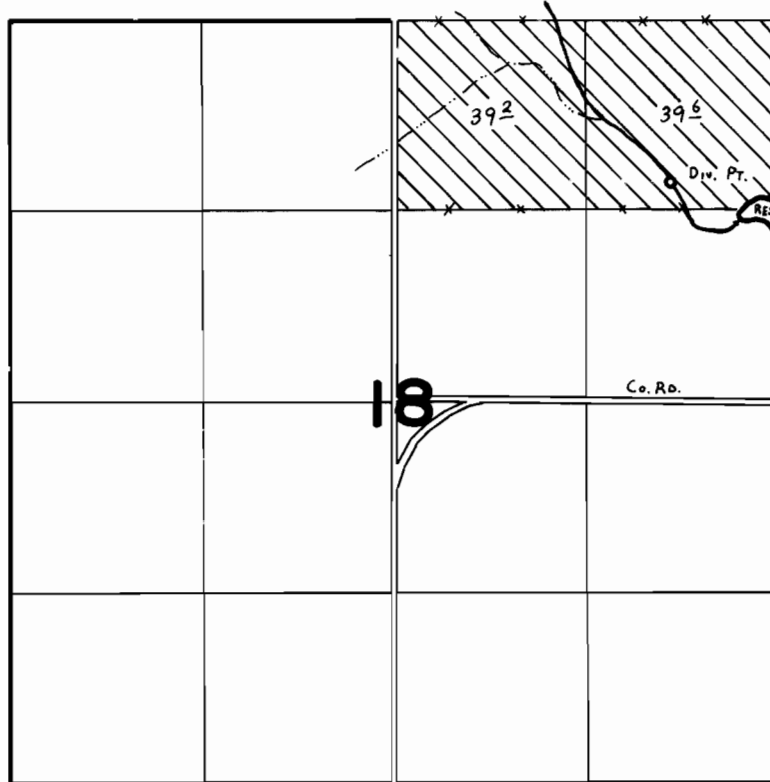

Div. Pt. Loc: 1500' N. & 1890' E. fr. C. 1/4 Co. R. Sec. 18.

FINAL PROOF SURVEY UNDER

Application No. 54952 Permit No. 41244
IN NAME OF

LLOYD COLLINS

Surveyed JUNE 24 1978, by C. L. HUGHES