


Section 21, T5S, R41E, WM
Union County

1 inch = 400 feet

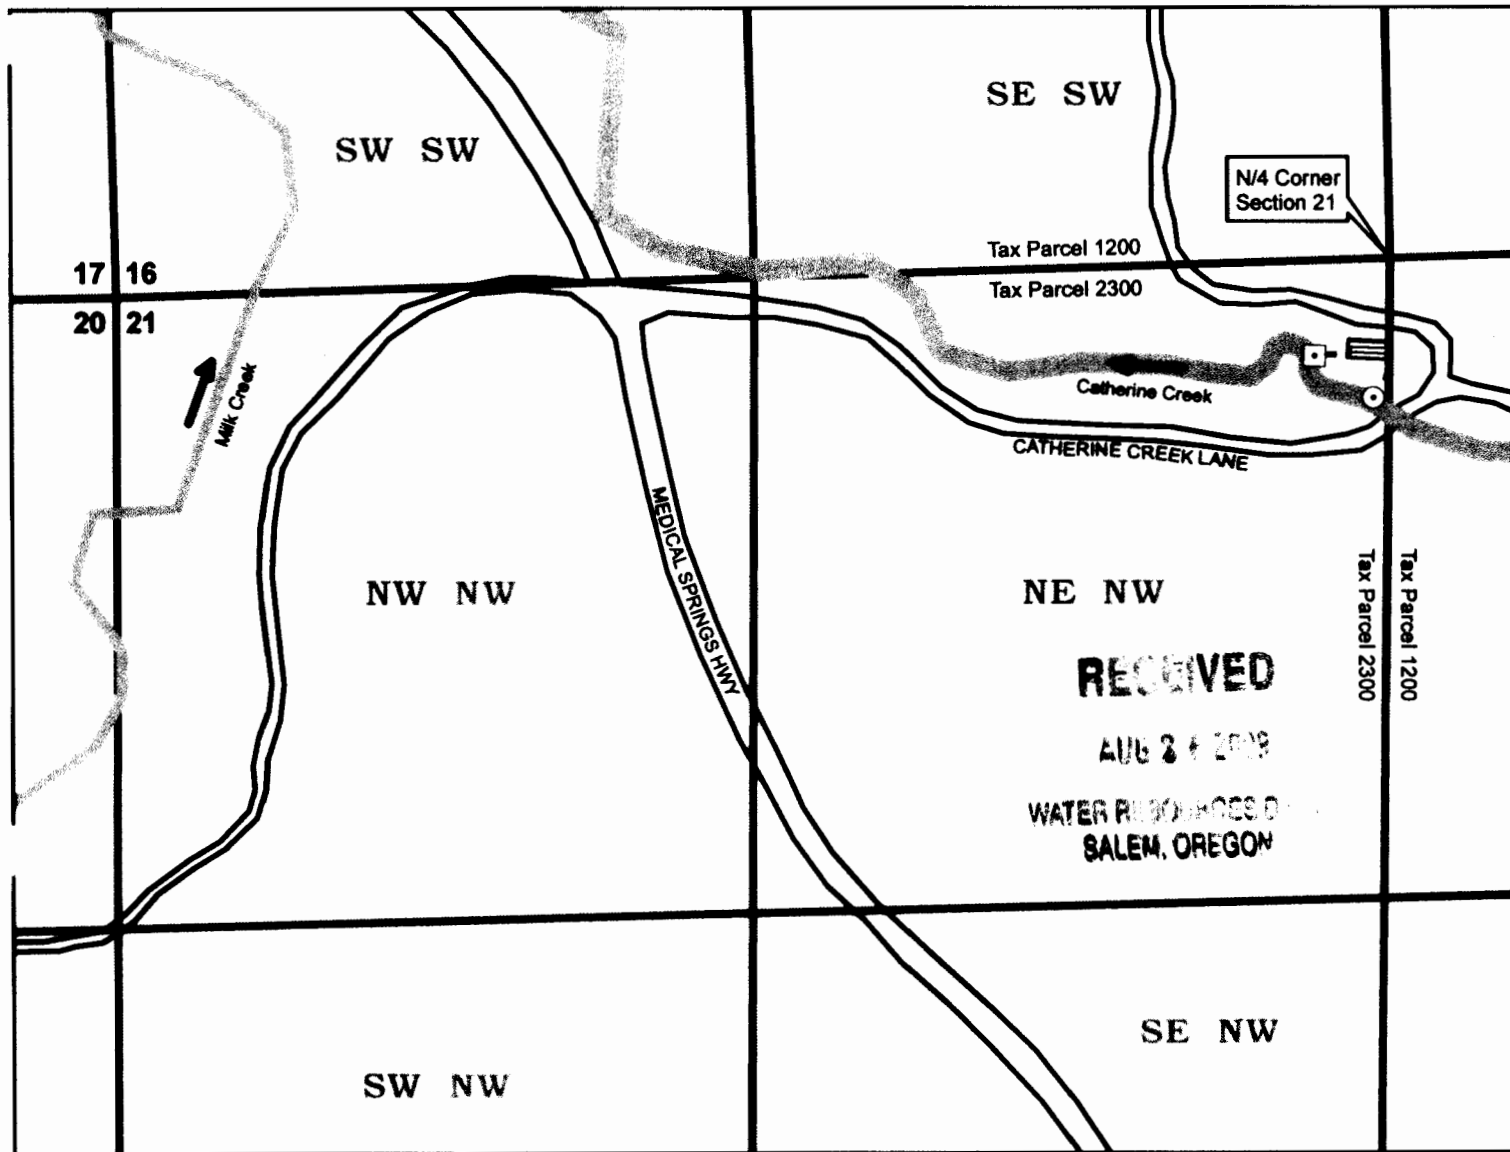

○ **Point of Diversion**

Pump suction with fish screen in NE/4 of NW/4 of Section 21, at a location 295 feet S and 30 feet W from N/4 Corner of Section 21.

--- **Conveyance**

Water conveyed from Catherine Creek to place of use (acclimation pond) with buried 12-inch HDPE pipeline. Water conveyed back to Catherine Creek with four parallel 8-inch HDPE pipelines which flow to common outfall.

 **Place of Use**


Raceways used for fish rearing and/or acclimation located in Tax Lot 2300, NE/4 NW/4, Section 21, T5S, R41E, WM.

□ **Outfall**

Raceway effluent returns to Catherine Creek 180 feet downstream from POD.

The purpose of this map is to identify the location of a water right. It is not intended to provide information regarding the location of property ownership boundary

FOUNTAINHEAD
1204 Alvarado Terrace
Walla Walla, WA 99362
509.529.2646 phone

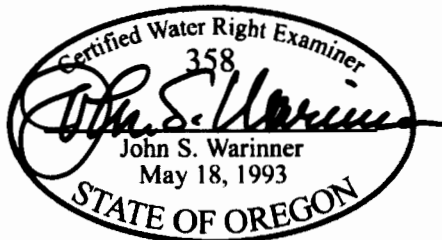

CLAIM OF BENEFICIAL USE
App S-84433 Permit S-53875

in the name of
BONNEVILLE POWER ADMIN

Revised 18 JUN 2009