


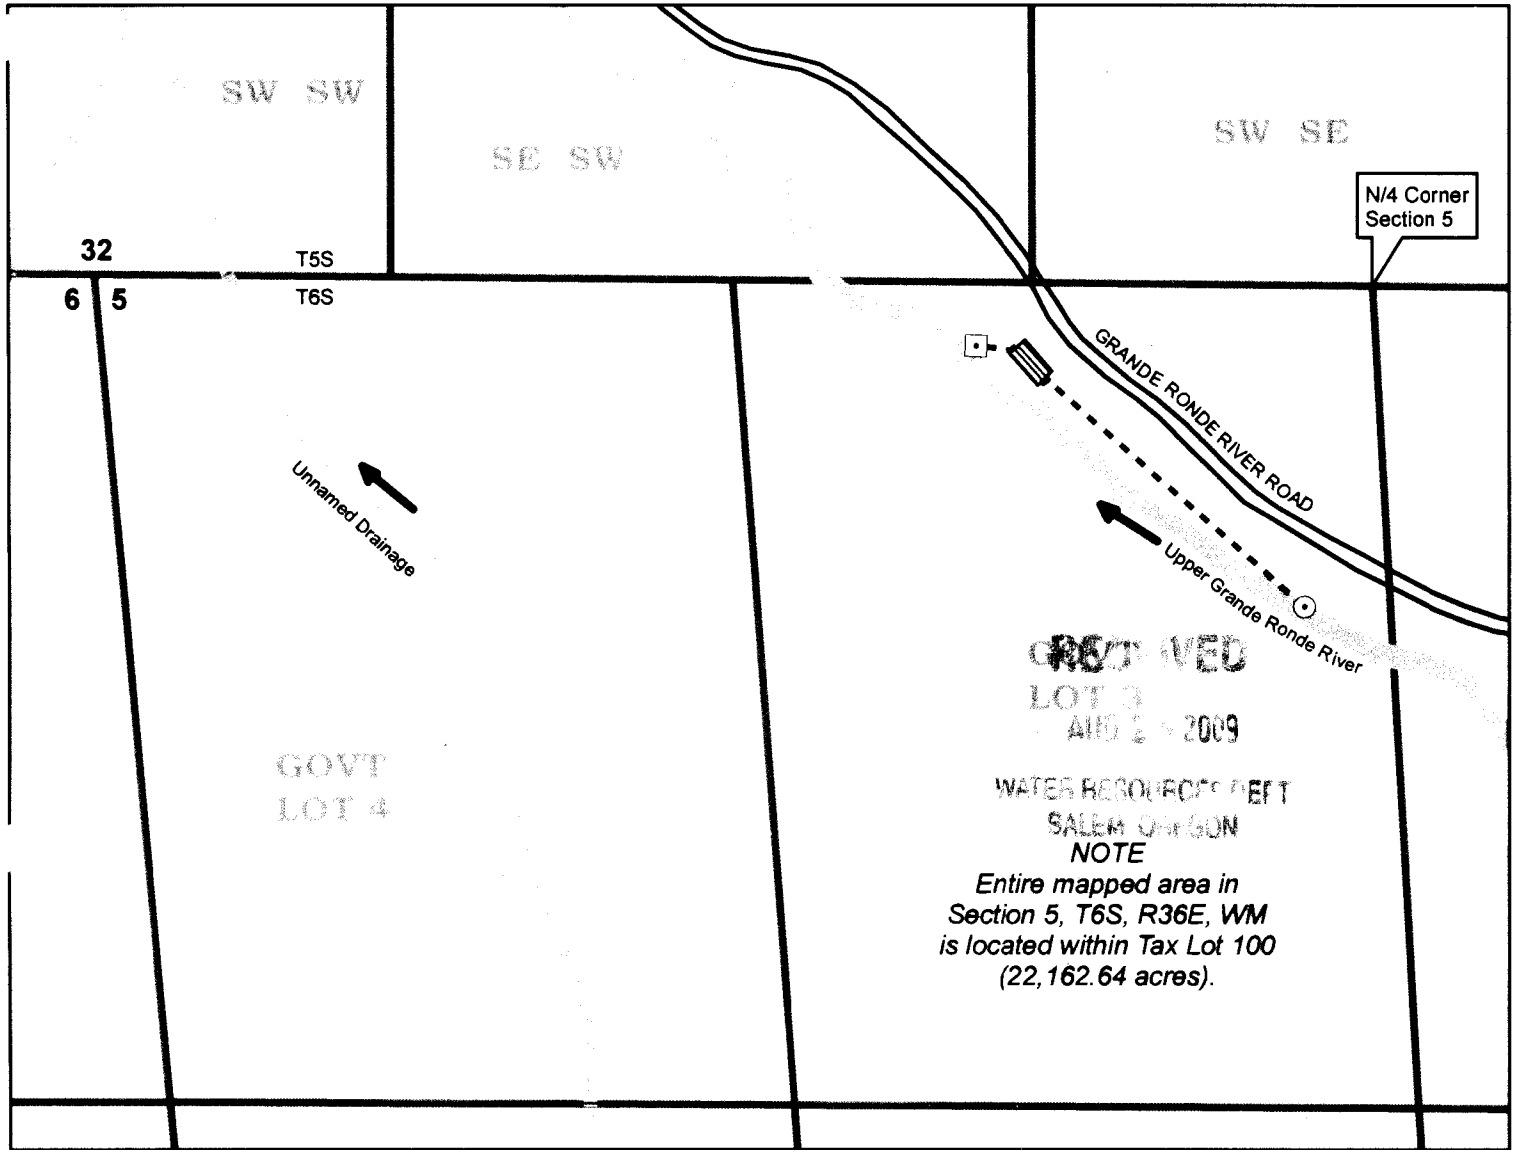


Section 5, T6S, R36E, WM
Union County

1 inch = 400 feet



○ **Point of Diversion**
Gravity diversion in Lot 3 of Section 5, at a location 675 feet S and 120 feet W from N/4 Corner of Section 5. Flat plate fish screen at same location.


--- **Conveyance**
Water conveyed from Upper Grande Ronde River to place of use (acclimation pond) with buried gravity-fed pipeline (16-inch diameter HDPE).

 **Place of Use**
Raceways used for fish rearing and/or acclimation located in Tax Lot 100, Government Lot 3, Section 5, T6S, R36E, WM.

■ **Outfall**
Raceway effluent returns to Upper Grande Ronde River 870 feet downstream from POD.

The purpose of this map is to identify the location of a water right. It is not intended to provide information regarding the location of property ownership boundary

FOUNTAINHEAD
1204 Alvarado Terrace
Walla Walla, WA 99362
509.529.2646 phone

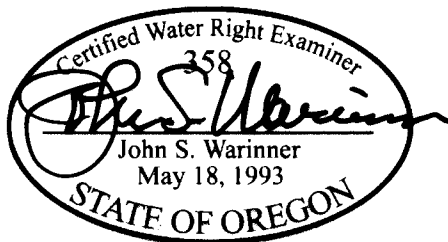

CLAIM OF BENEFICIAL USE
App S-84435 Permit S-53877

in the name of
BONNEVILLE POWER ADMIN

Revised 18 JUN 2009