


Instream Transfer Application Map Authorized Place of Use and Point of Diversion

Diversion A
Certificate #9954

✓ *RL*

Township 36 South, Range 15 East (W.M.)

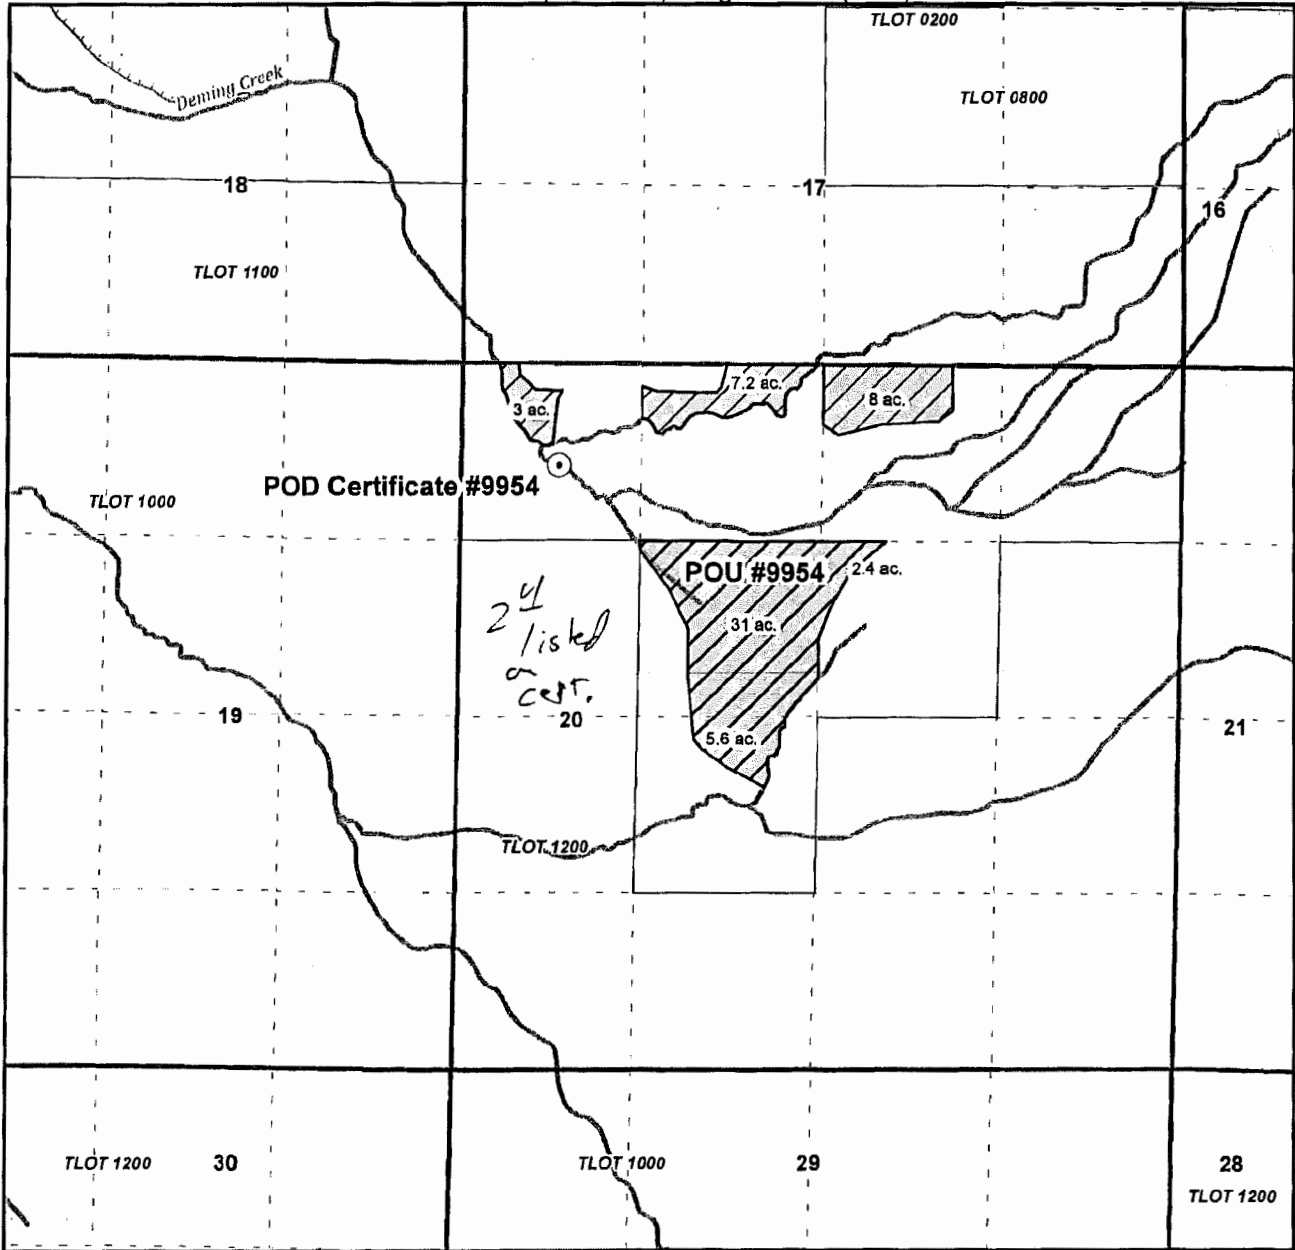

Path: D:\GIS\Deming Mapping\Map files\DemingTransfer_9954.mxd

Legend

- Authorized Place of Use (POU) #9954
- Authorized Point of Diversion (POD) #9954
- Tax Lots
- Streams
- Canal/ditch

POD Location Description

POD: 9954
Location: 42.441901°, -120.961370°

Disclaimer

This map was prepared for the purpose of identifying the location of a water right only and is not intended to provide legal dimensions or location of property ownership.

Map Notes

Date: March 12, 2014
Data Sources: Klamath County, OWRD, & USGS GIS
Prepared By: Klamath Basin Rangeland Trust

RECEIVED BY OWRD

MAY 05 2014

SALEM, OR

N

KBRT Klamath Basin Rangeland Trust