

# Instream Transfer Application Map


## Authorized Place of Use and Point of Diversion

### Deming Creek - Upper Anderson Field South Diversion

#### Certificate #9958

*✓ J.S.*

Township 36 South, Range 15 East (W.M.)

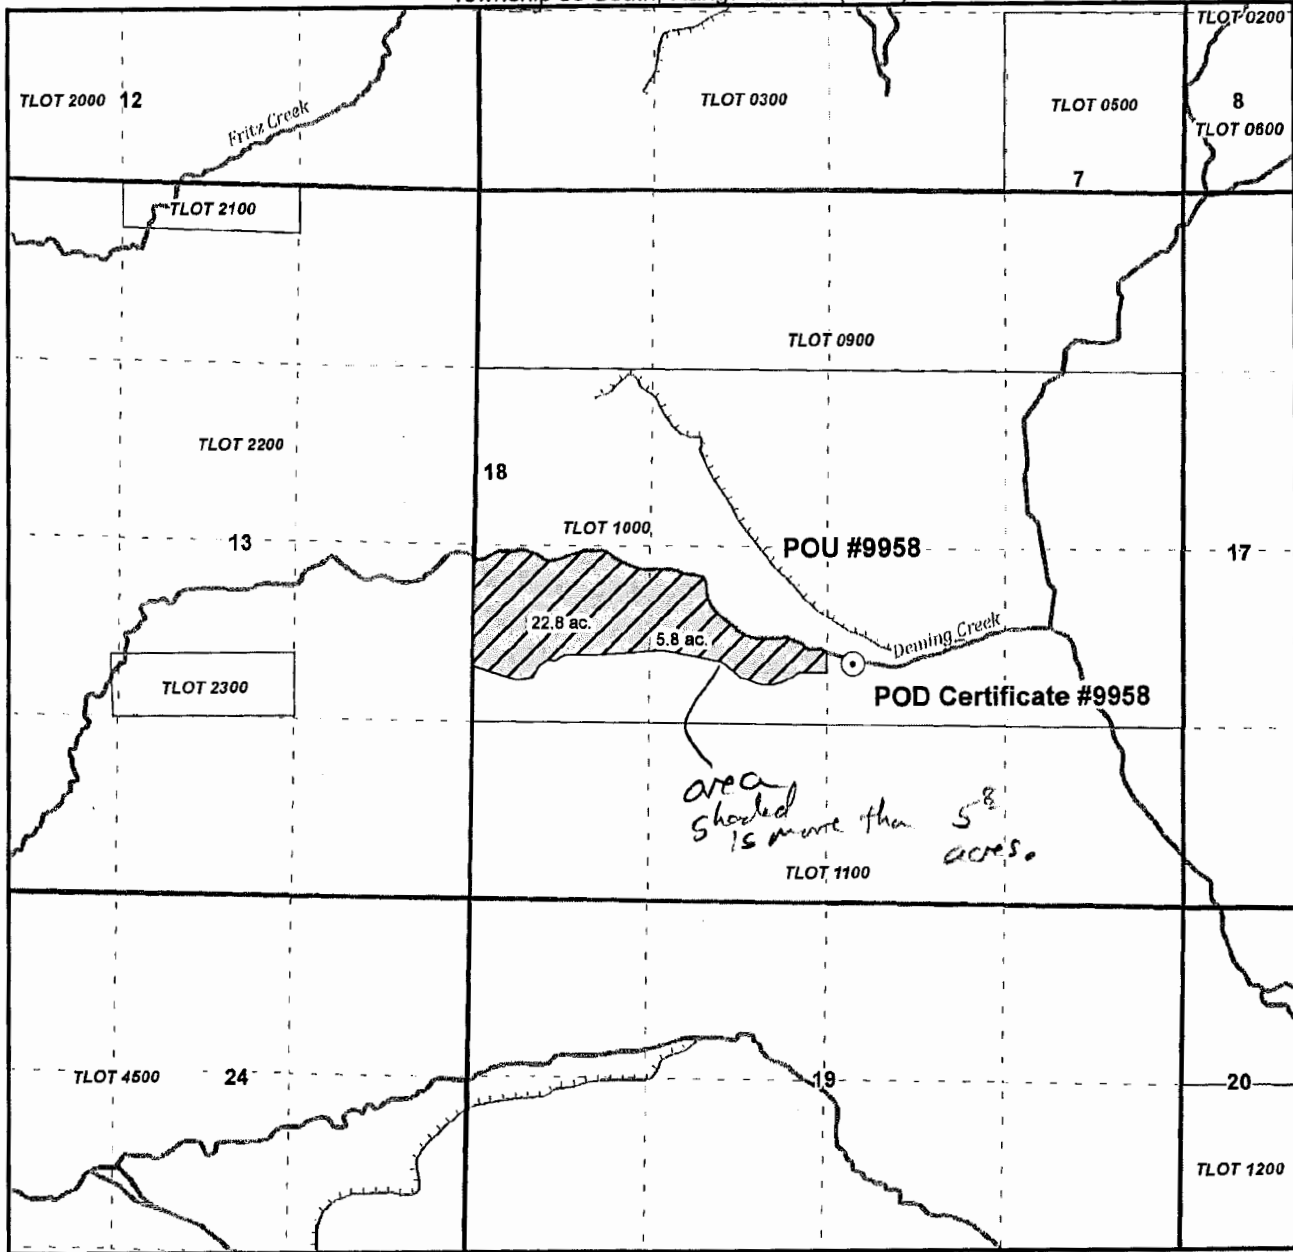

Path: D:\GIS\Deming Mapping\Map files\DemingTransfer\_9958.mxd

**Legend**

- Authorized Place of Use (POU) #9958
- Authorized Point of Diversion (POD) #9958
- Tax Lots
- Streams
- Canal/ditch

**Disclaimer**

This map was prepared for the purpose of identifying the location of a water right only and is not intended to provide legal dimensions or location of property ownership.

**Map Notes**

Date: March 12, 2014  
 Data Sources: Klamath County, OWRD, & USGS GIS  
 Prepared By: Klamath Basin Rangeland Trust

**POD Location Description**

POD Cert.#: 9958  
 Location: 42.446274°, -120.985264°

RECEIVED BY OWRD

MAY 05 2014

SALEM, OR

N

0 660 1320  
Feet

**KBRT** Klamath Basin Rangeland Trust