


T36S. R.14E. W.M.

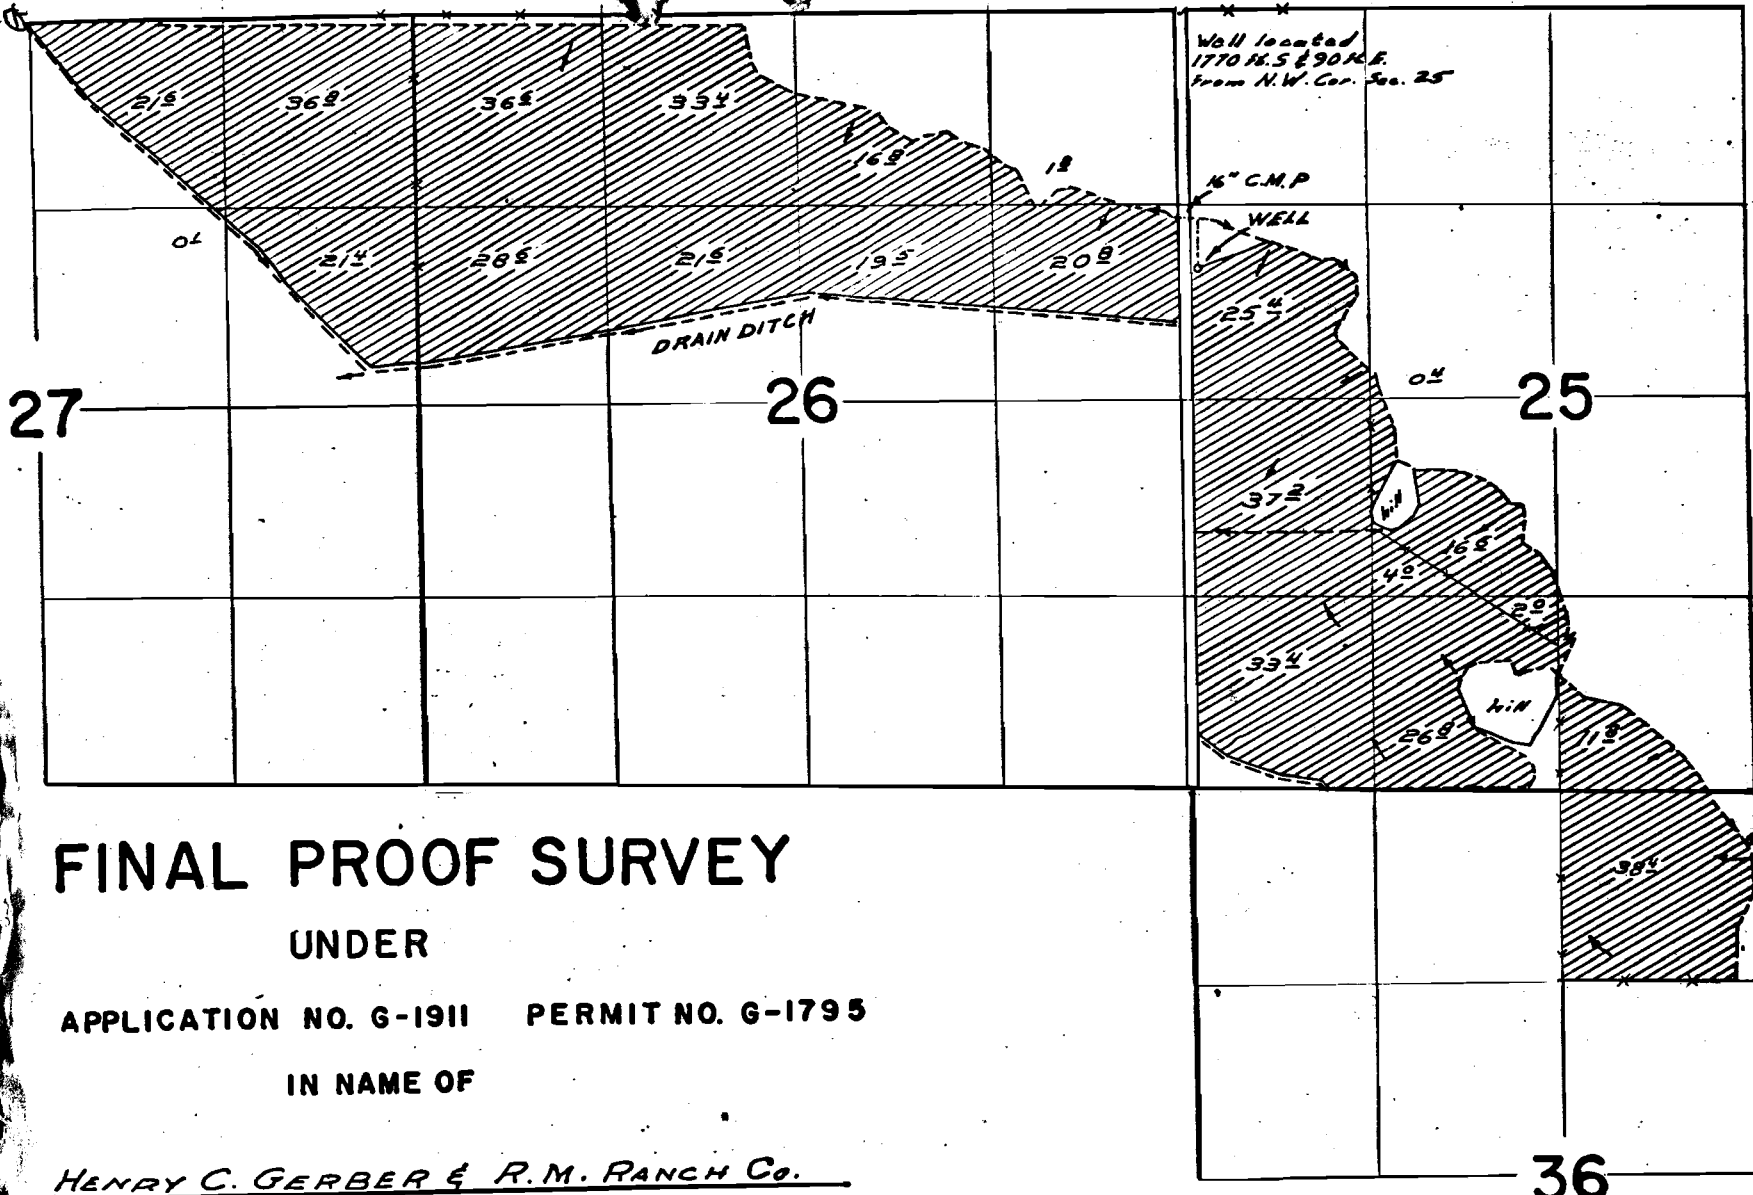

Well located  
1770 ft. S & 90 ft. E  
from N.W. Cor. Sec. 25

16" C.M.P.  
WELL

**FINAL PROOF SURVEY**  
 UNDER  
 APPLICATION NO. G-1911 PERMIT NO. G-1795  
 IN NAME OF

HENRY C. GERBER & R.M. RANCH Co.

SURVEYED OCT. 26 & 28 BY W.J. Ruppert  
1966

S. J. Sprague, P.M. Wells

G-1795  
399210