

G-2974

43608

35785


T.4N.R.28E.W.M.

**CANCELLED**

Sp. Or. 1/26 P. 1/22

T-3327

ADDL. P.O.D.

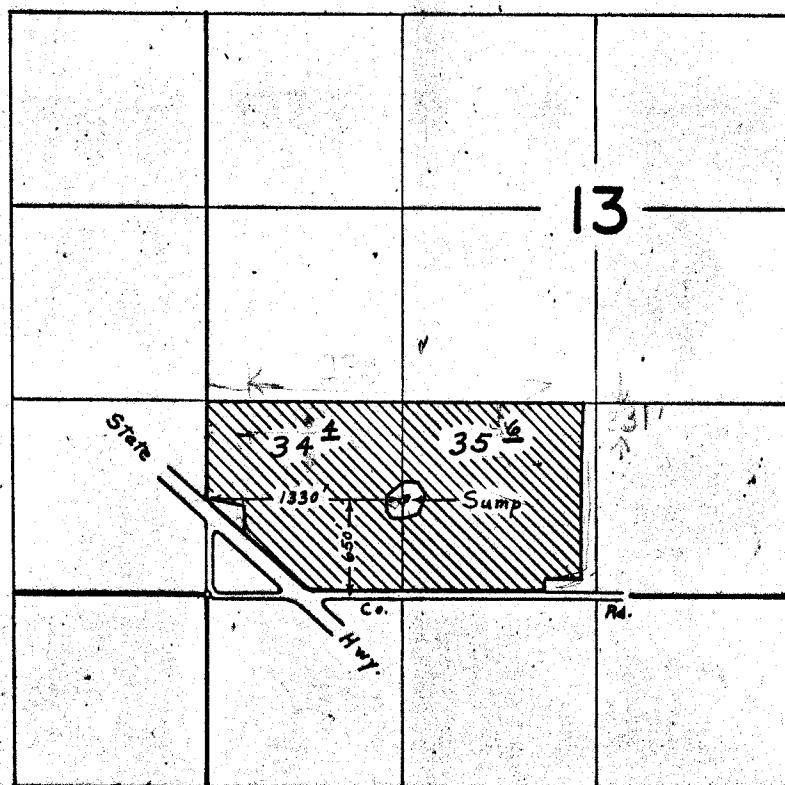

SCALE 1" = 1 mile

**FINAL PROOF SURVEY**  
UNDER

Application No. G-3161 Permit No. G-2974

IN NAME OF

**THOMAS N. ABLE, JR.**

Surveyed JUNE 27, 1967, by L. E. Gould.