


418

CORV. MAP # 0418

SECTIONS 19, 20, 29 & 30, TWP.3S. R.16E. W.M.
SHERMAN COUNTY, OREGON

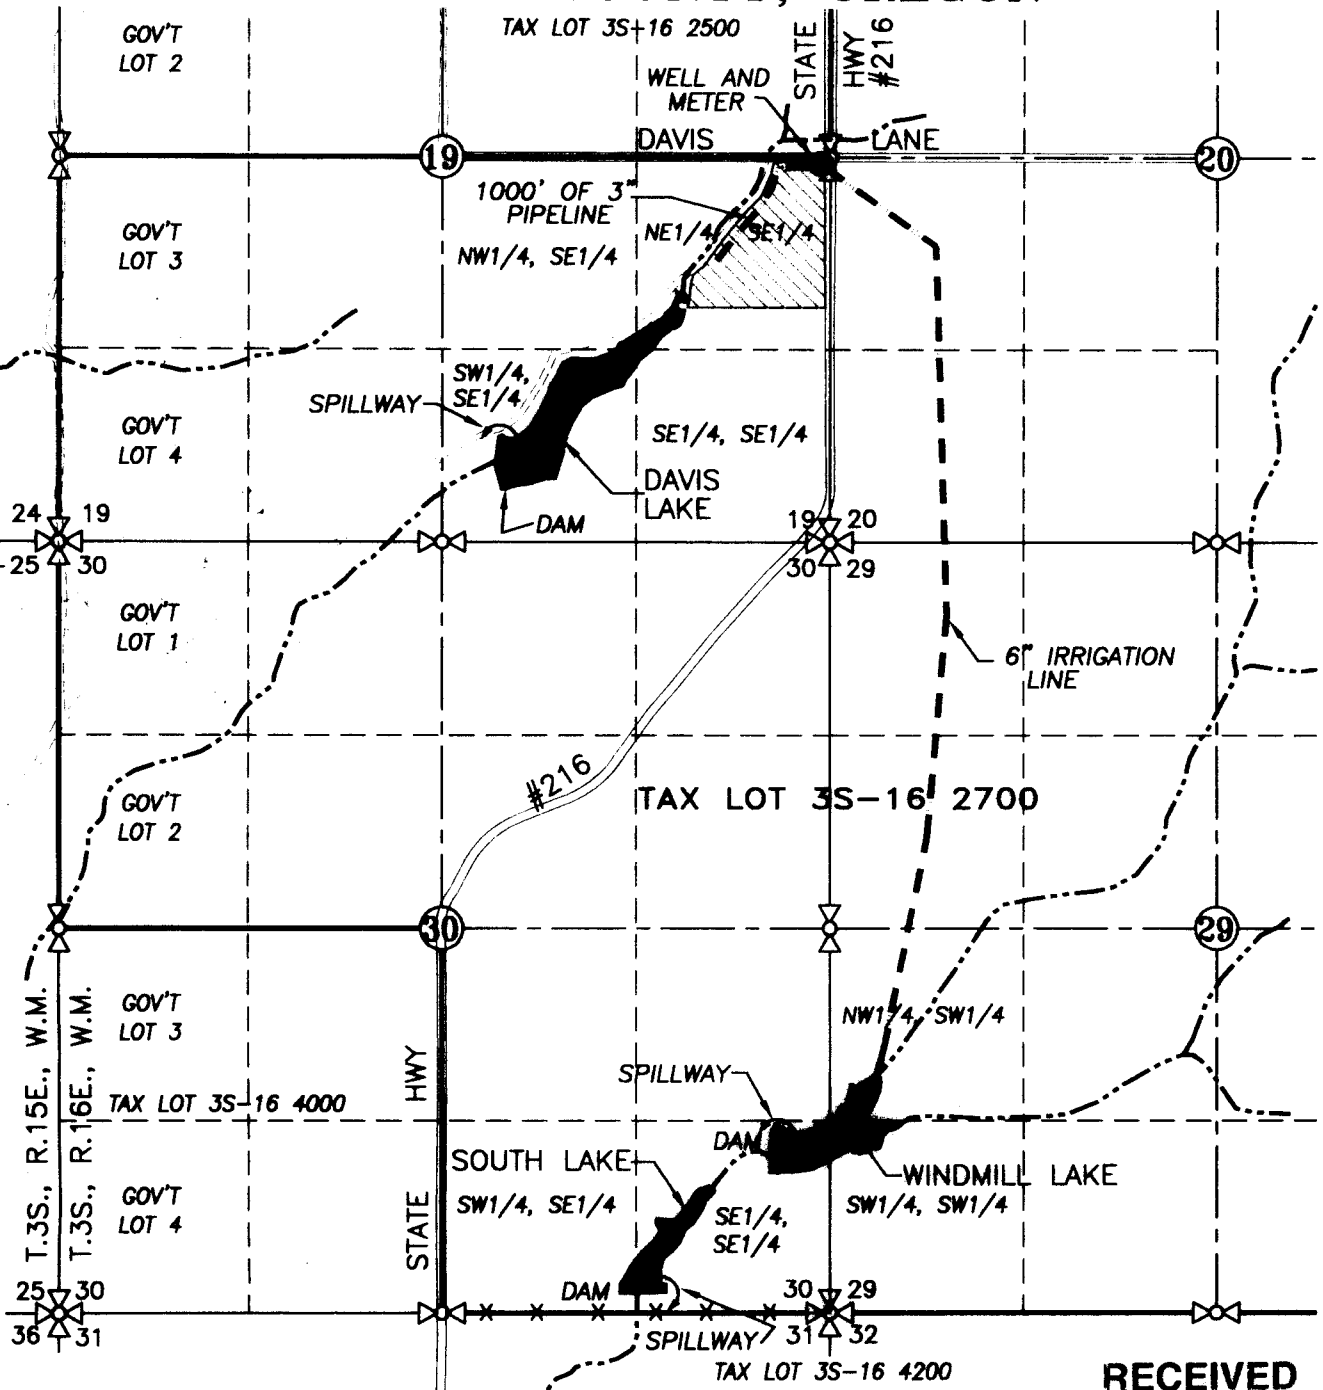

● WELL: 50'S. & 50'W. OF NE COR. OF S1/2, SEC. 19

 IRRIGATED AREA = 15.0 ACRES

 IRRIGATION MAIN

DAVIS LAKE: 522' N. AND 2255' W. OF THE SE CORNER SECTION 19

SOUTH LAKE: 165' N. AND 1275' W. OF THE SE CORNER SECTION 30

WINDMILL LAKE: 1120' N. AND 365' W. OF THE SE CORNER SECTION 30

CLAIM OF BENEFICIAL USE MAP

SCALE: 1" = 1320'

APPLICATION No. G-15529

PERMIT No. G-15624

IN THE NAME OF:

FRED JUSTESEN

DATE: FEBRUARY 26, 2009


BY: **TENNESON ENGINEERING CORP.**

3313 W. 2ND. STREET, SUITE 100

THE DALLES, OREGON. 97058

PH. (541) 296-9177

FAX (541) 296-6657

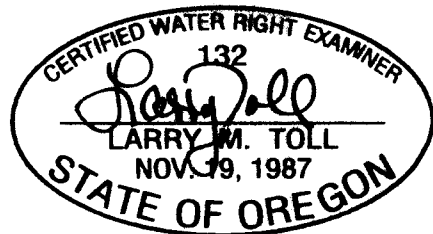

EXPIRES: 06/30/2010

NOTE:

"THIS MAP IS NOT INTENDED TO
PROVIDE DIMENSIONS OR LOCATIONS
OF PROPERTY OWNERSHIP LINES."

MAP #1

W.O. #11132wr2

RECEIVED

WATER RESOURCES DEPT
SALEM, OREGON