



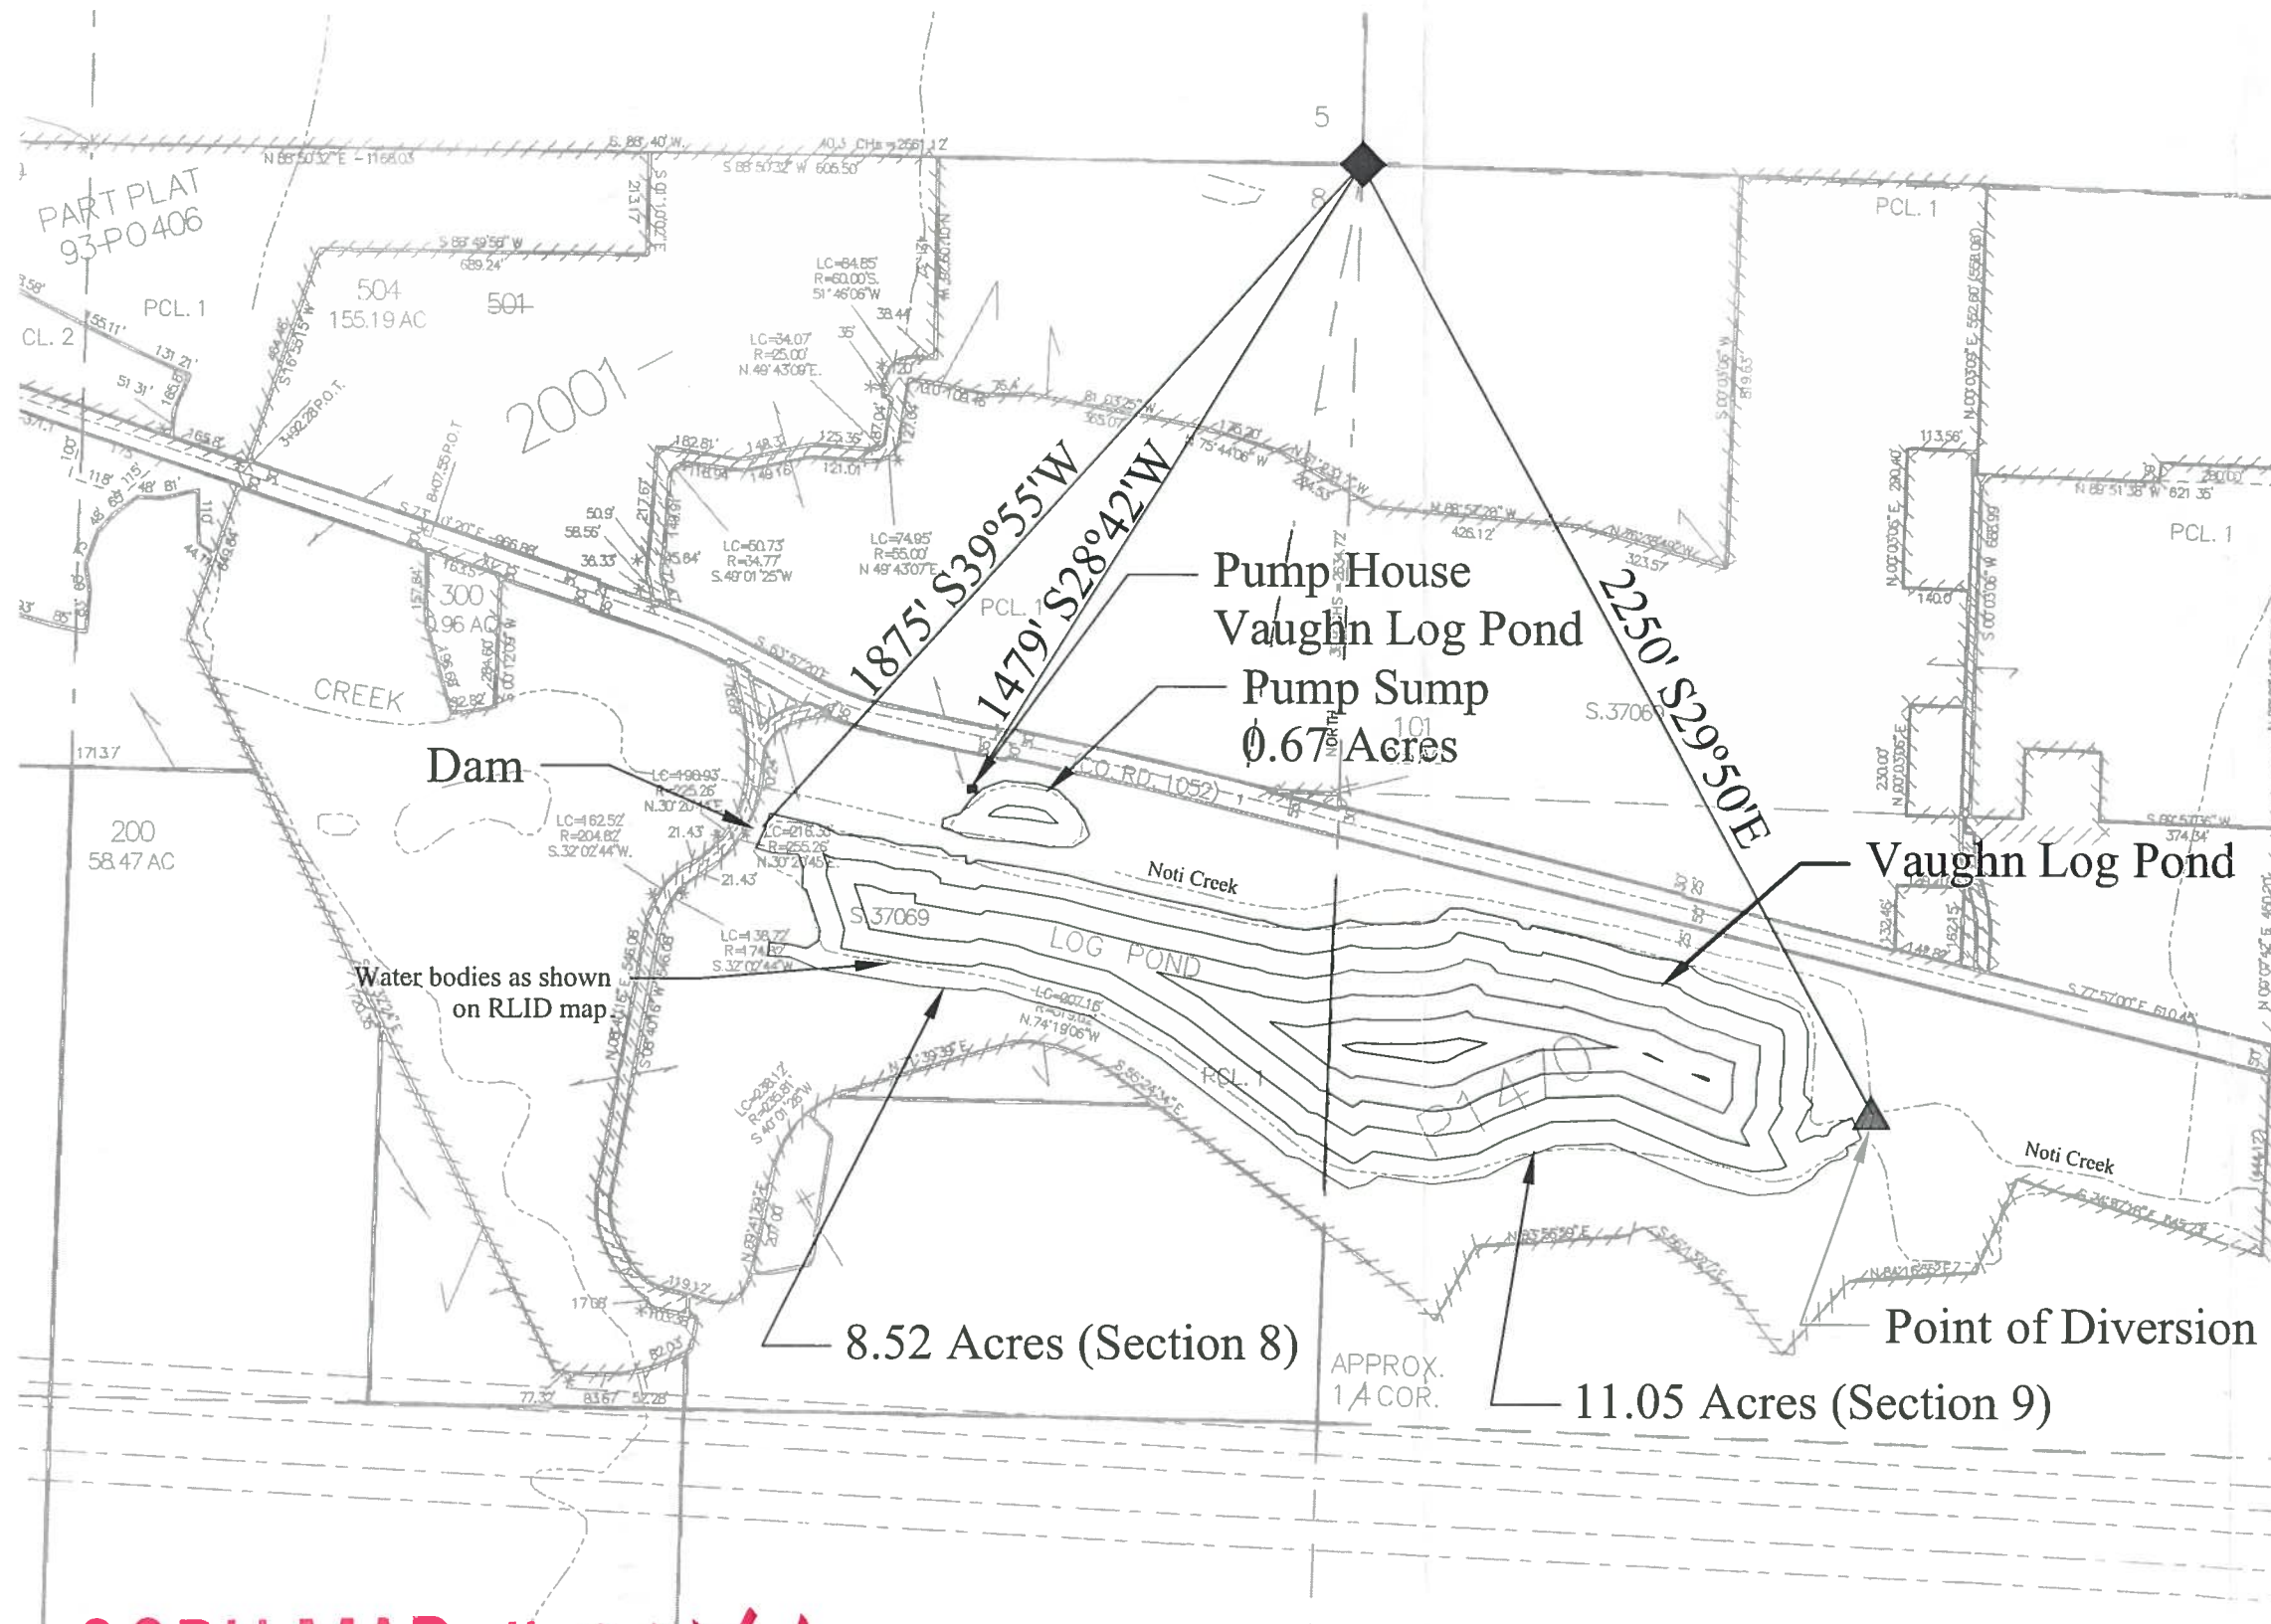

T.18S., R.6W., W.M.
Sections 8 & 9
Rosboro Lumber CO. LLC
Tax Lot 504
Map 18060800
Lane County, Oregon
April 27, 2009

Application # T-7878
Permit # R-774

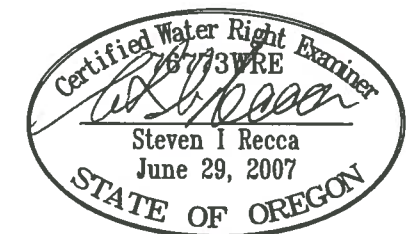

EXPIRATION DATE: 12/31/10

RECEIVED

OCT 01 2009

**WATER RESOURCES DEPT
SALEM, OREGON**



BASE MAPPING BY LANE COUNTY TAX MAPS 18060800 AND 18060900. THIS MAP HAS BEEN PREPARED FOR THE SOLE PURPOSE OF IDENTIFYING THE REQUESTED WATER RIGHT LOCATION. THERE IS NO INTENT TO PROVIDE DIMENSIONS OR LOCATIONS OF PROPERTY OWNERSHIP LINES.

EGR & Associates, Inc.
Engineers, Geologists and Surveyors

2535B Prairie Road
Eugene, Oregon 97402

(541) 688-8322
Fax (541) 688-8087