



5-8551/c.u.
W&D

CLAIM OF BENEFICIAL USE MAP

FOR
CLAYTON CASWELL

LOCATED IN
SEC. 32, T. 4 S., R. 5 W., W.M.
YAMHILL COUNTY, OREGON

APRIL 2, 2010

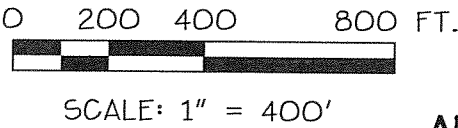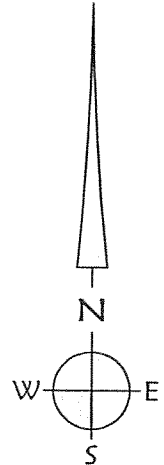

APPLICATION AND PERMITTEE:

CLAYTON L. CASWELL
2596 THURSTON ST. SE
ALBANY, OREGON 97321

TAX LOT:


FOR POINT OF DIVERSION: TAX LOT 6200 (4-5W-29)
FOR POINT OF USAGE: TAX LOT 300 (4-5W-33)

LEGEND:

—W— BURIED WATER LINE FROM P.O.D. TO RESIDENCE

DISCLAIMER:

THIS MAP IS NOT INTENDED TO PROVIDE LEGAL DIMENSIONS
OR LOCATIONS OF PROPERTY OWNERSHIP.

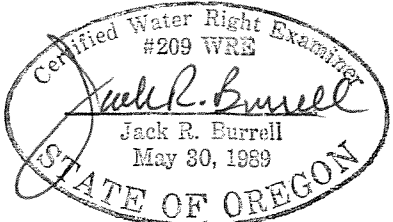

RENEWAL DATE 12/31/11

RECEIVED


APR 06 2010

WATER RESOURCES DEPT
SALEM, OREGON

COBU MAP # 0494

K & D

K & D ENGINEERING, Inc.
276 N.W. Hickory Street P.O. Box 725
Albany, Oregon 97321
(541) 928-2583

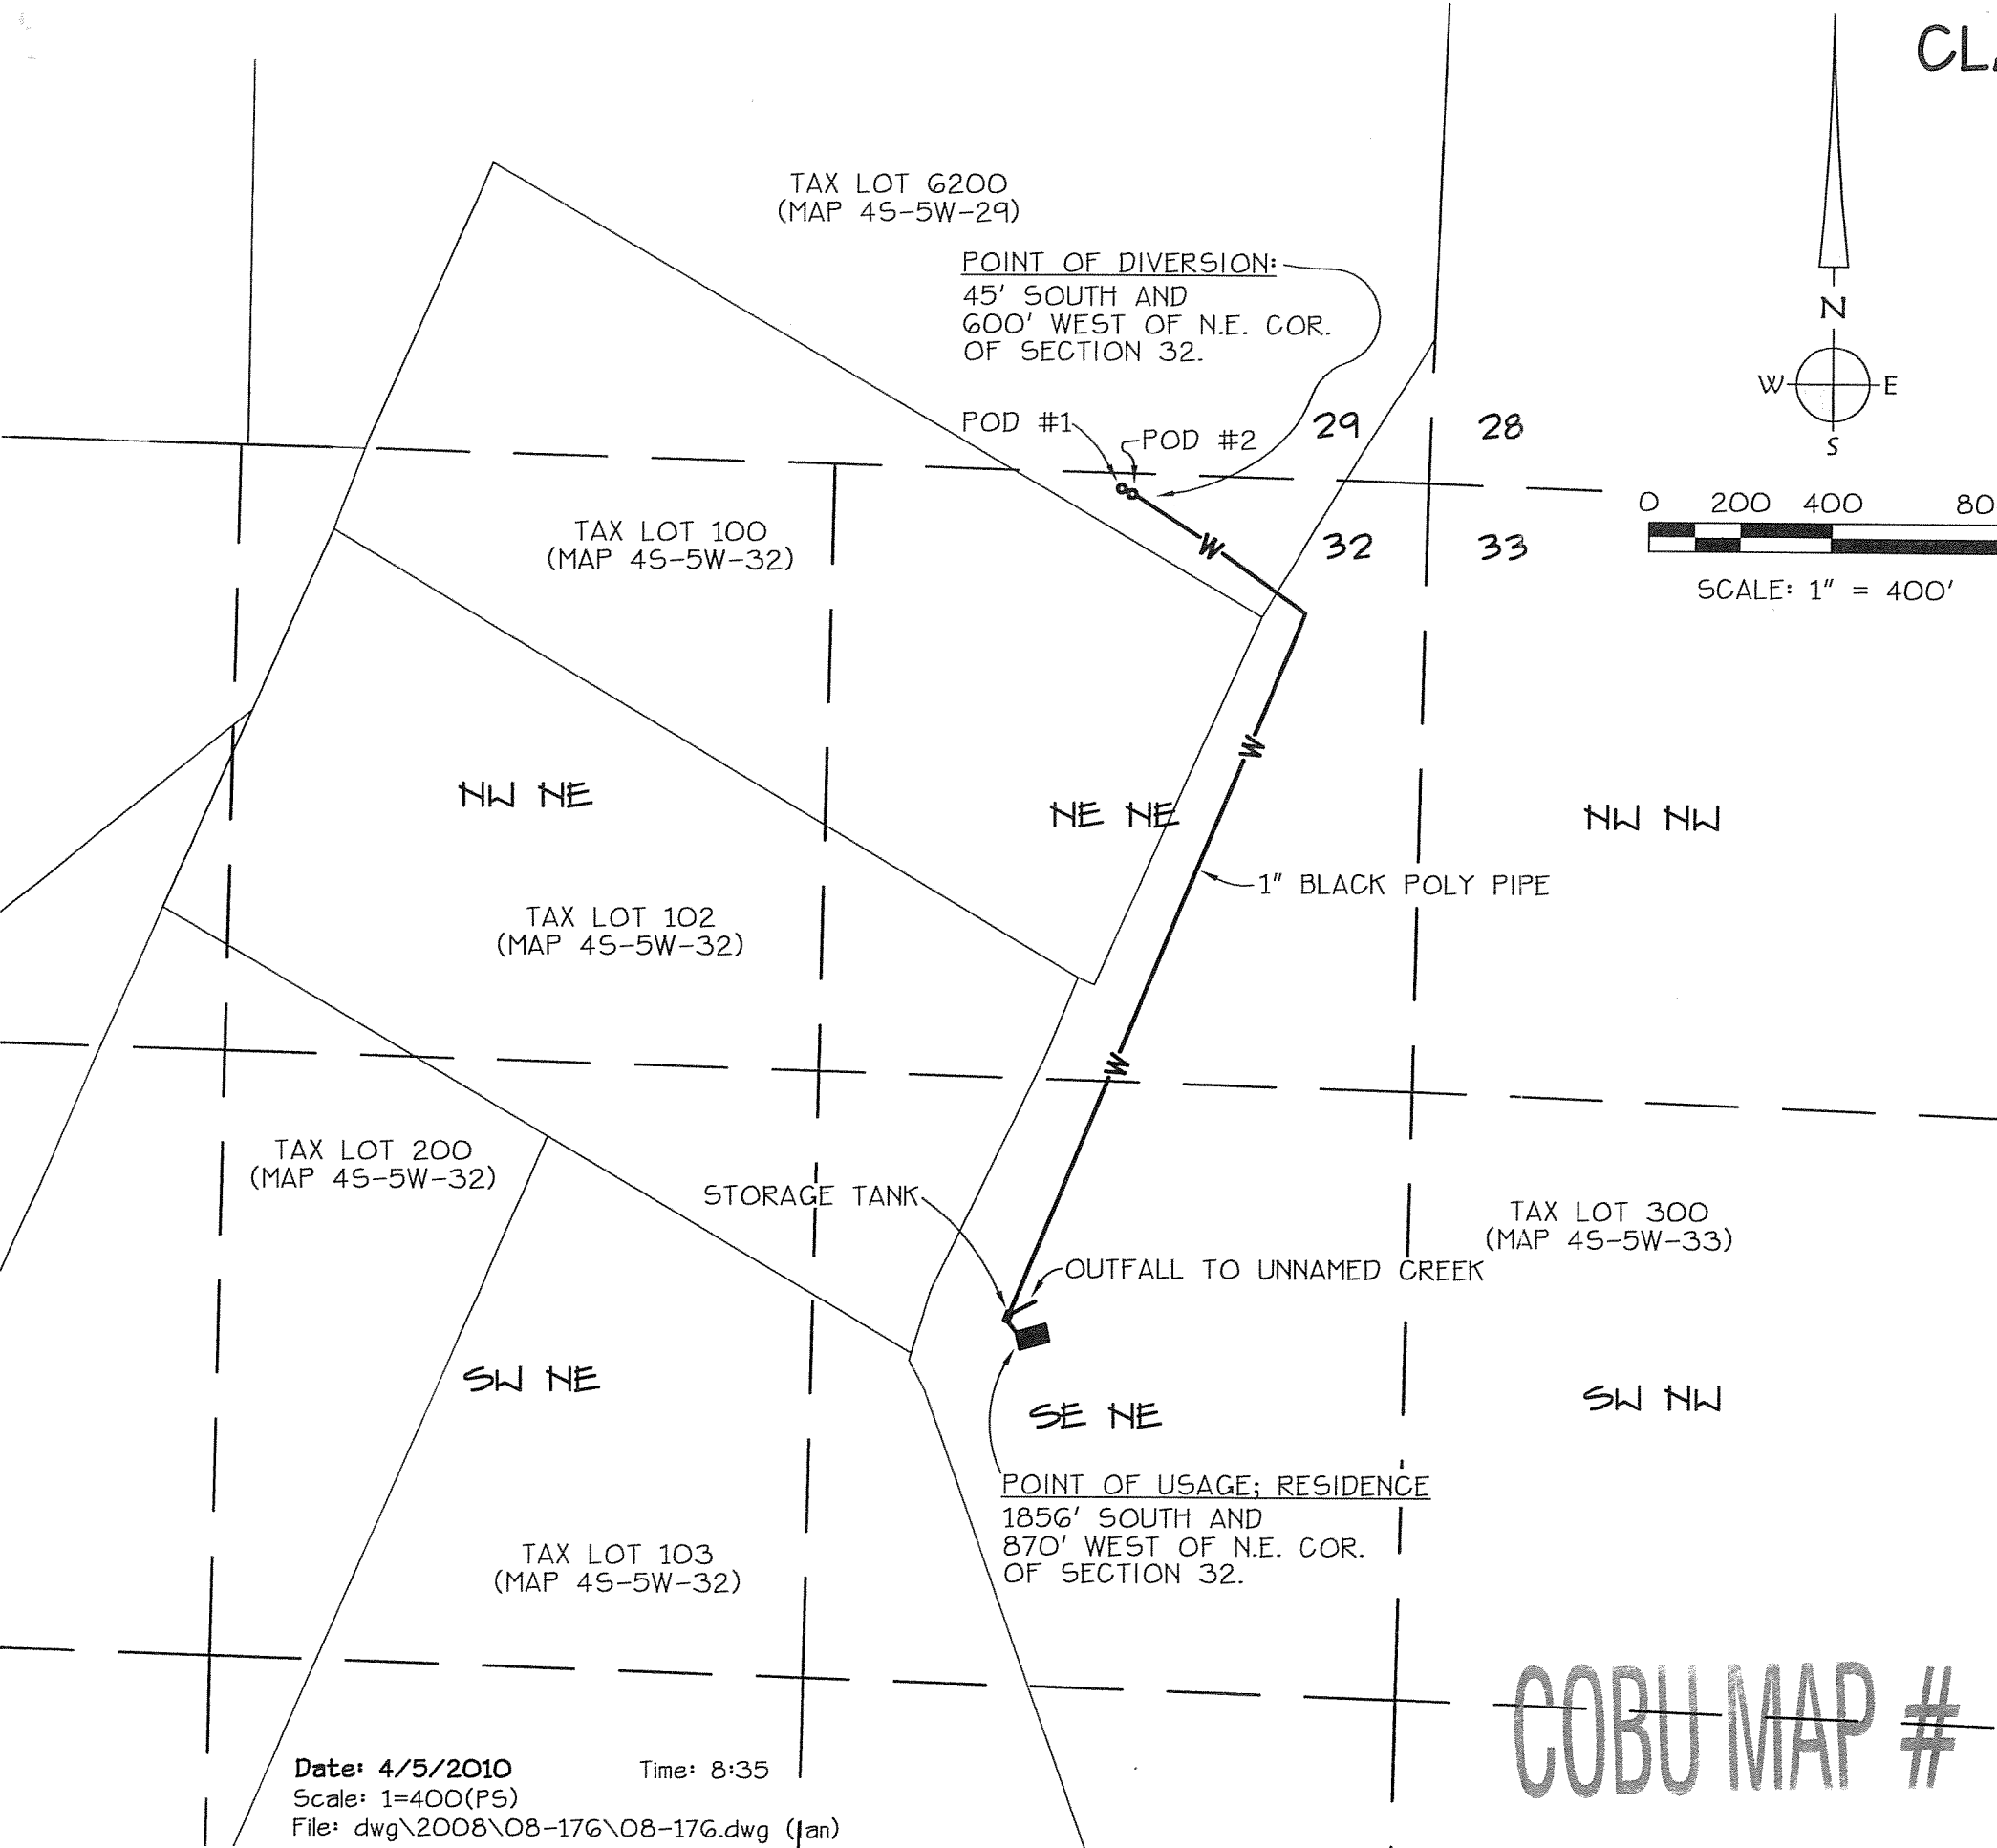

Date: 4/5/2010 Time: 8:35
Scale: 1=400(P.S.)
File: dwg\2008\08-176\08-176.dwg (Jan)