


# Claim of Beneficial Use

- 1 - APPLICATION R-84307
- 2 - APPLICATION R-84308
- 3 - APPLICATION R-84309

- PERMIT R-12883
- PERMIT R-12884
- PERMIT R-12885

TOWNSHIP 26 S., RANGE 6 W., W.M. - SECTION 34  
DOUGLAS COUNTY, OREGON

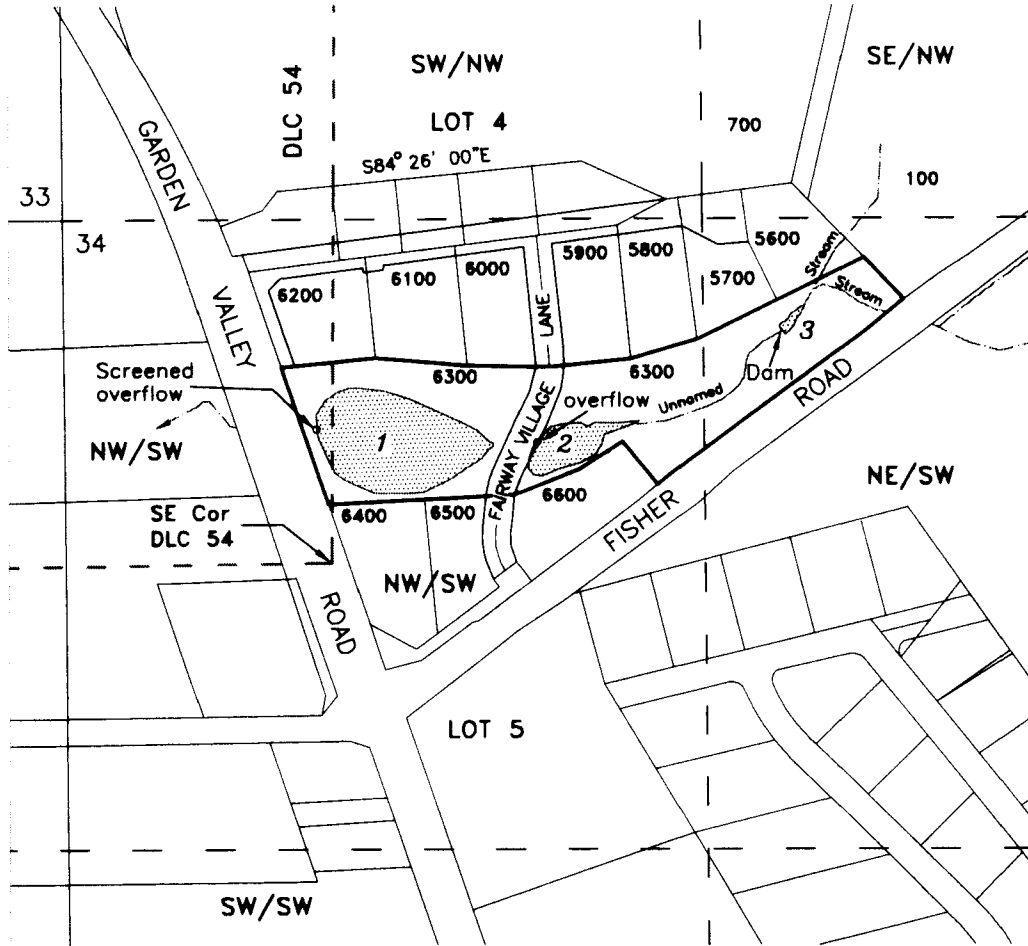

|   |  |  |
|---|--|--|
| <p>1 - LOWER RESERVOIR - 2.3 AF<br/>Overflow - NW/SW, DLC 54, 280 ft. N &amp; 30 ft. W from the SE Cor. DLC 54</p>  | <p>Assigned to:</p> <p>FAIRWAY VILLAGE HOME OWNERS ASSOCIATION<br/>275 FAIRWAY VILLAGE LANE<br/>ROSEBURG, OR 97471</p> | <p>Assessor Map #<br/>T-26S, R6W-34C</p> |
| <p>2 - MIDDLE RESERVOIR - 0.9 AF<br/>Overflow - NW/SW, Lot 5, 250 ft. N &amp; 425 ft. E from the SE Cor. DLC 54</p>   |  |  |
| <p>3 - UPPER RESERVOIR - 0.05 AF<br/>Center dam - NE/SW, 485 ft. N &amp; 935 ft. E from the SE Cor. DLC 54</p>  |  |  |
| <p>Source - Unnamed Stream<br/>Purpose - Aquatic Life, Recreation &amp; Wildlife</p>  |  |  |
| <p>Base map - Douglas County GIS Tax Lots over 8/12/2015 Oregon Map &amp; 7/15/2015 Google aerial photos for assumed best fit. Subdivision Map Vol. 20 Page 48B Plat overlay used for control &amp; orientation</p> |  |  |

This map is not intended to provide legal dimensions or locations of property ownership lines