


T. 20S, R. 39E., W.M.

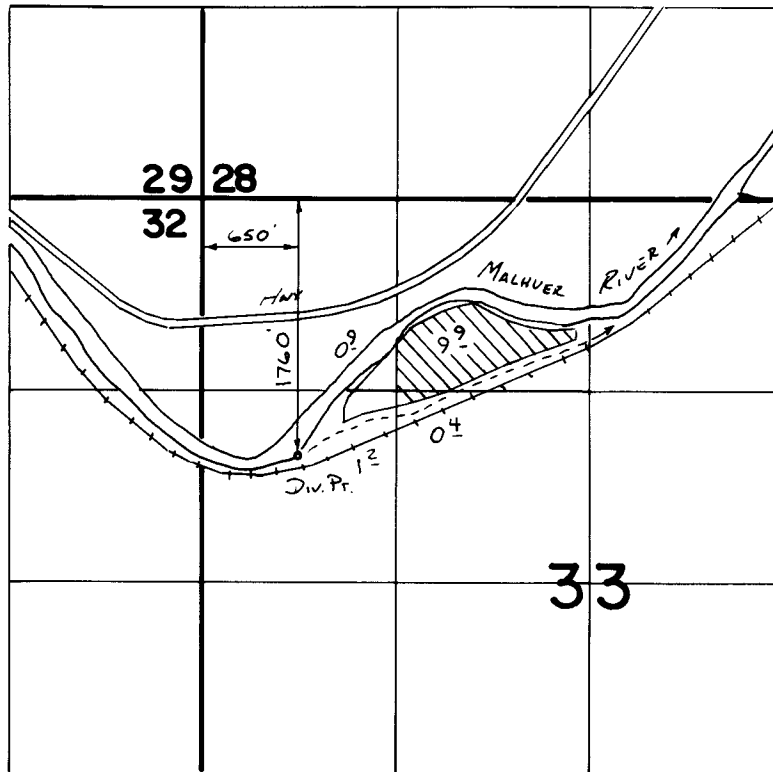

SCALE 1" = 1320'

**FINAL PROOF SURVEY**  
UNDER

**TRANSFER 4679**  
IN NAME OF

.....**D.E. JONES & SON, INC.**.....

Surveyed *5-24*..... 19*88*, by *V.H. Church*.....