



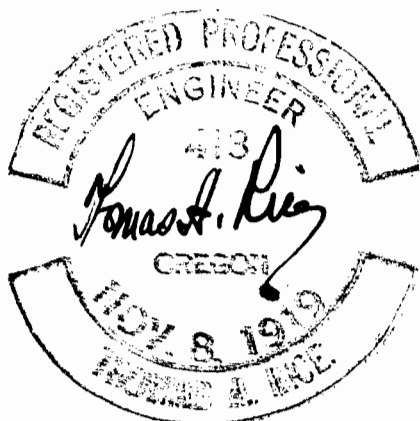

Intake for pump house
 Bearing $S 12^{\circ} 13' W$
 Distance to Sec. Cor 32-33 - 1634.5 ft.

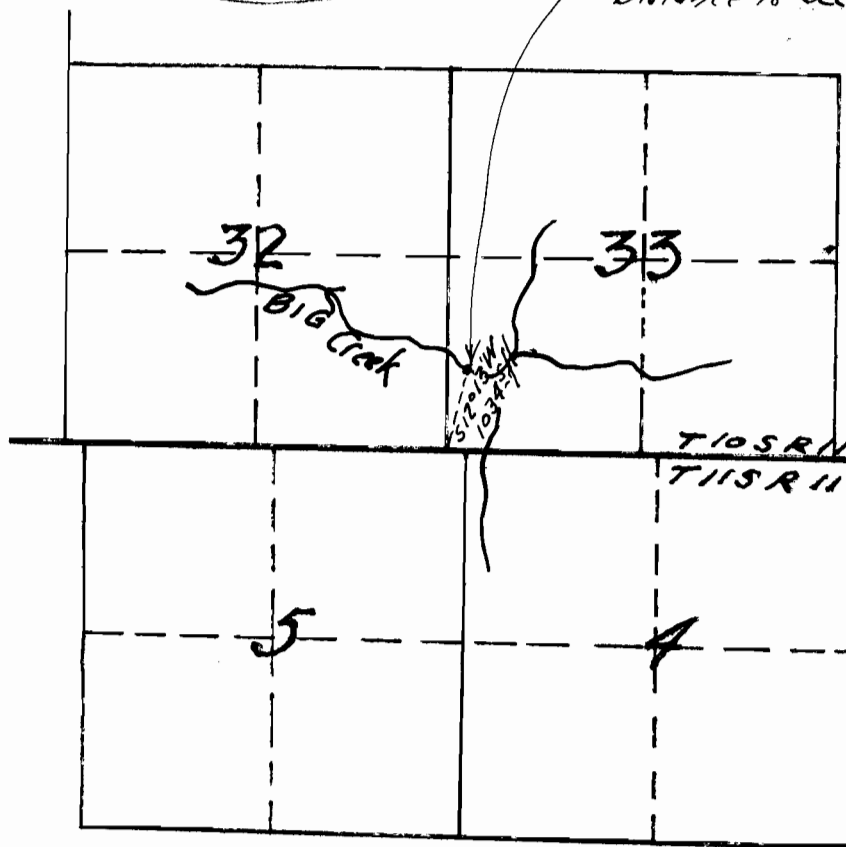

T10S R11W. H.M. Scale 2" = 1 mile.
 T11S R11W. H.M.



Map to accompany
 Application for permit to
 appropriate water from BIG CREEK
 Lincoln County, State of Oregon

11/11/56
 7722