


CLAIM OF BENEFICIAL USE FINAL PROOF MAP

Located in the NW $\frac{1}{4}$ SW $\frac{1}{4}$ of Section 9
Township 23 South, Range 12 West, W.M.


Coos County, Oregon

Application S-81551 Permit 53311

TENMILE LAKE

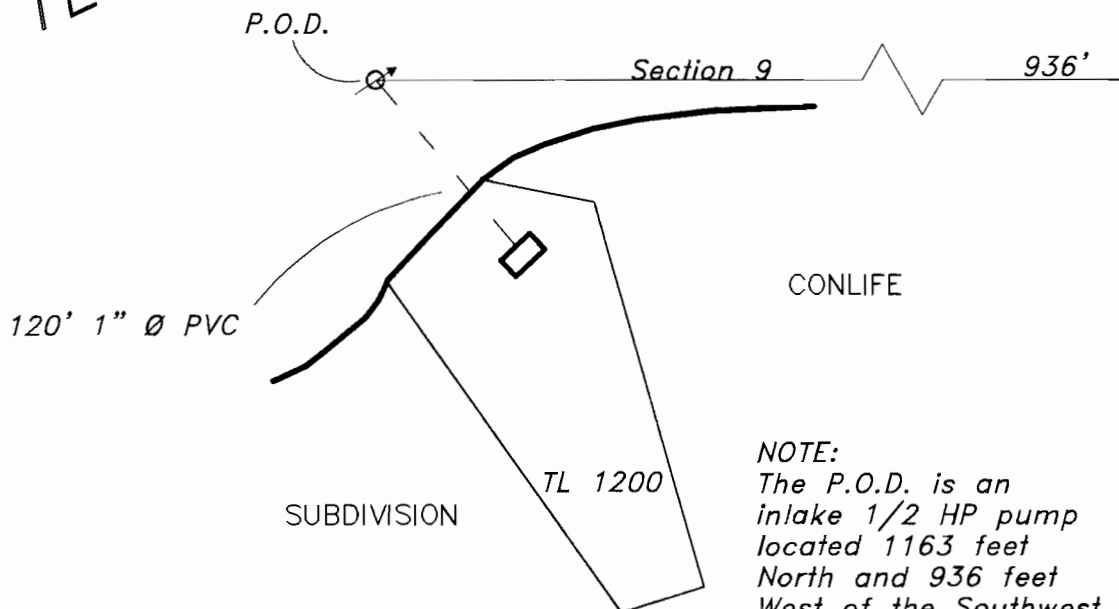

NOTE:
The P.O.D. is an
inlake 1/2 HP pump
located 1163 feet
North and 936 feet
West of the Southwest
1/16 corner of Sec. 9.

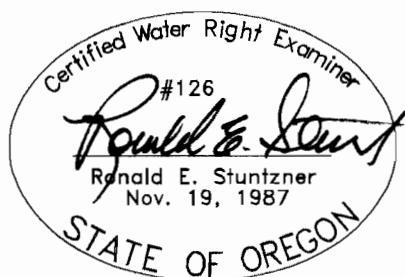

EXPIRES 06/30/00

RECEIVED

JAN 04 1999

WATER RESOURCES DEPT.
SALEM, OREGON

P.O.B.

SW 1/16
CORNER

LEGEND

P.O.B.

P.O.D.



Prepared For: Merrill & Deeanne Workhoven
Prepared By: Dennis Goude
Date Prepared: November 20, 1998

EXAMINERS DISCLAIMER STATEMENT

The preparation of this map was for the purpose of
identifying the location of the Water Right only and
has no intent to provide dimensions or location of
property ownership lines.

Stuntzner Engineering
& Forestry, L.L.C.

ENGINEERING • LAND SURVEYING • FORESTRY
PLANNING • WATER RIGHTS

705 South 4th St.
Post Office Box 118
Coos Bay, Oregon 97420

Phone: (541) 267-2872
Fax: (541) 267-0588