


RECEIVED

JUN 19 1998

WATER RESOURCES DEPT.
SALEM, OREGON

CLAIM OF BENEFICIAL USE FINAL PROOF MAP

Located in the NW1/4 of the SW1/4 of Section 9
Township 23 South, Range 12 West, W.M.
Coos County, Oregon
Application # S81277 Permit 53197

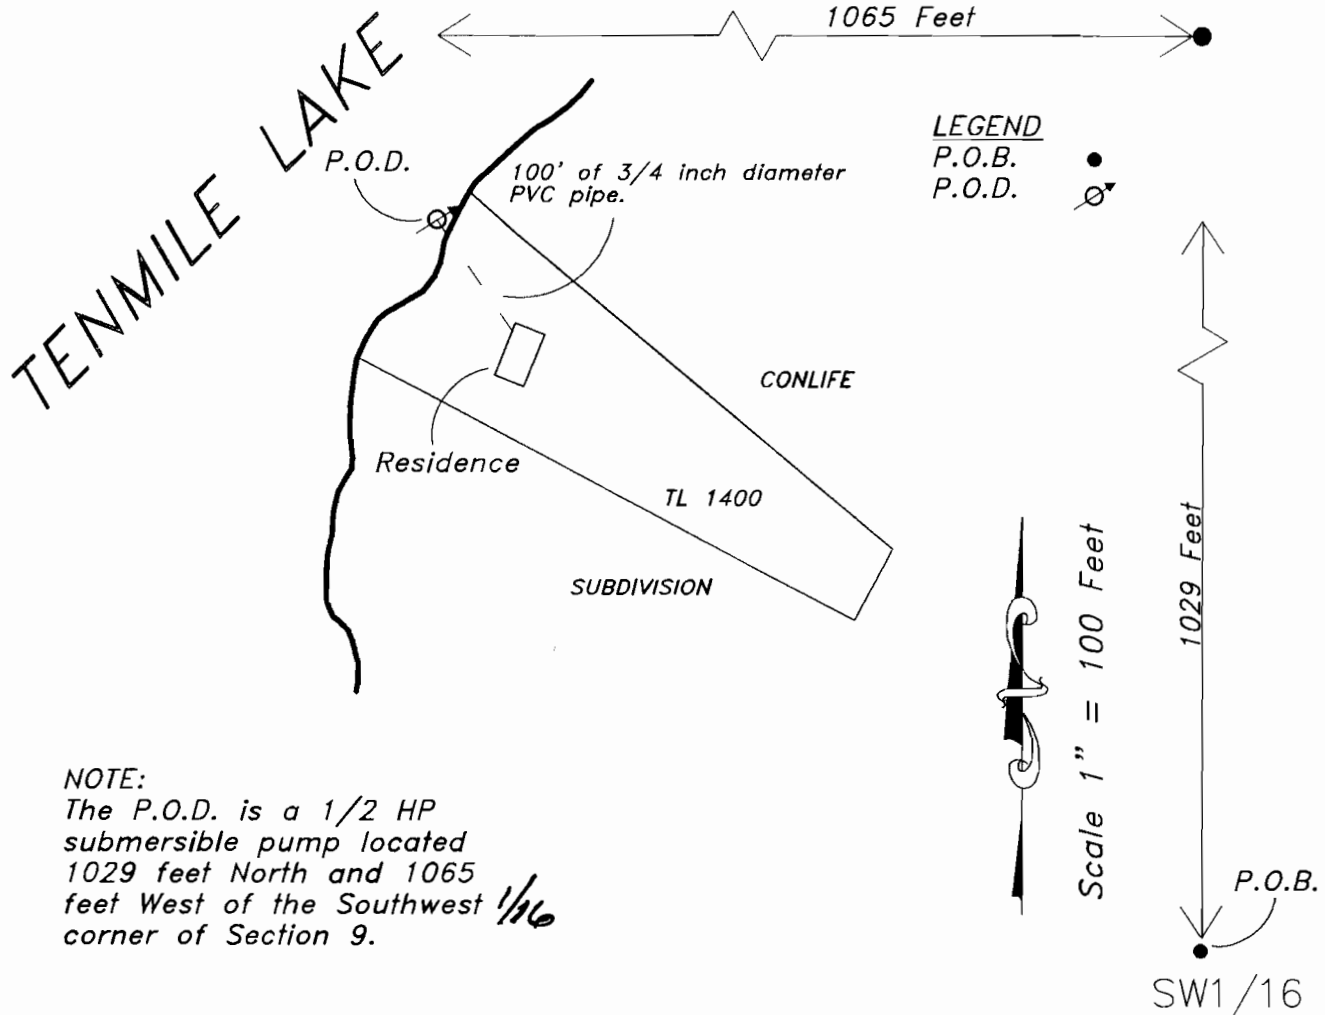

NOTE:

The P.O.D. is a 1/2 HP submersible pump located 1029 feet North and 1065 feet West of the Southwest ^{1/16} corner of Section 9.



Prepared For: Carl O. George
Prepared By: Dennis Goude
Date Prepared: June 12, 1998

EXPIRES 06/30/99

EXAMINERS DISCLAIMER STATEMENT

The preparation of this map was for the purpose of identifying the location of the Water Right only and has no intent to provide dimensions or location of property ownership lines.

Stuntzner Engineering
& Forestry, L.L.C.

ENGINEERING • LAND SURVEYING • FORESTRY
PLANNING • WATER RIGHTS

706 South 4th St.
Post Office Box 118
Coos Bay, Oregon 97420

Phone: (541) 267-2872
Fax: (541) 267-0588