

RECEIVED

OCT 26 2010

WATER RESOURCES DEPT
SALEM, OREGON

CLAIM OF BENEFICIAL USE

FOR: PAULETTO RANCH LLC

BY: DUANE W. KIRBY

T26S, R7W, W.M., SEC3

TAX LOTS 1400 AND 1800

APPLICATION NO. S-87470

PERMIT NO. S-54596


NO FISH SCREEN REQUIRED

METER IS LOCATED BETWEEN POND & HOUSE

A. CLAYTON

DLC 41

CENTER SEC 3

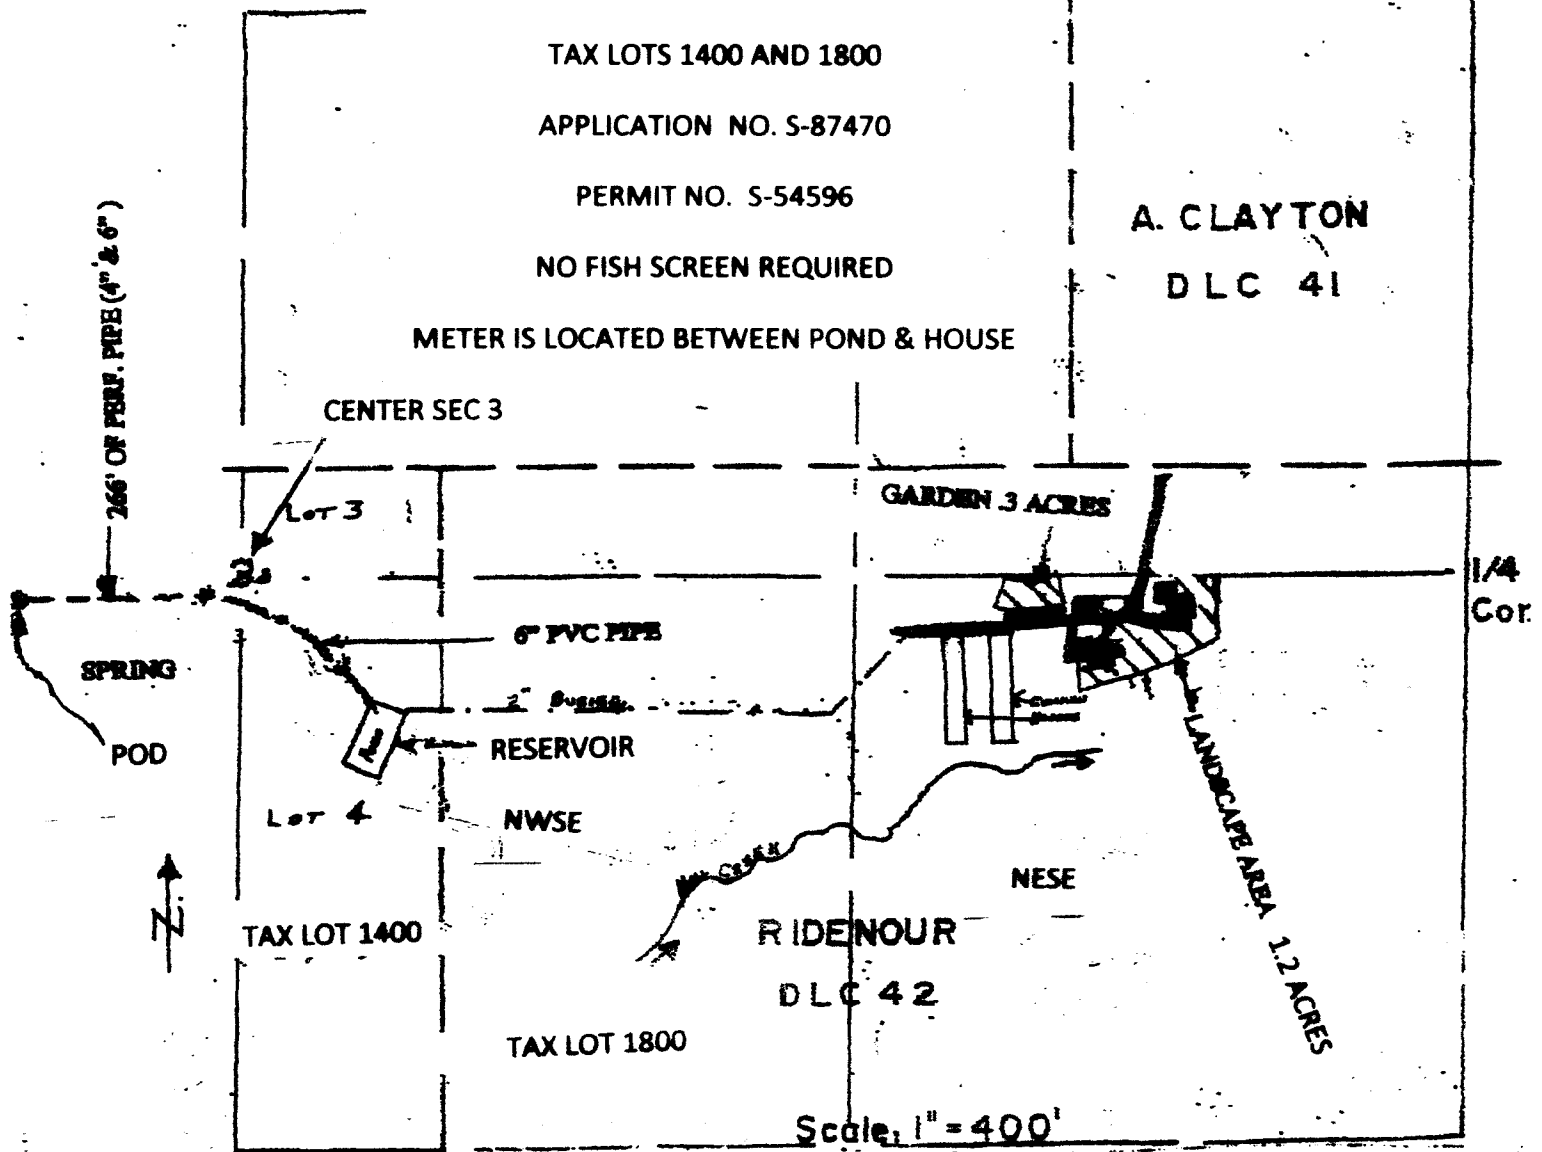

DIV. POINT LOCATED 420 FEET WEST AND 10 FEET SOUTH OF CENTER SECTION 3.

CENTER OF RESERVOIR IS 350 FEET SOUTH AND 280 FEET EAST OF CENTER OF SECTION 3.

THE PURPOSE OF THIS MAP IS TO
IDENTIFY THE LOCATION OF THE
WATER RIGHT. IT IS NOT INTENDED
TO PROVIDE INFORMATION RELATIVE
TO THE LOCATION OF PROPERTY
OWNERSHIP BOUNDARY LINES.

