


# FINAL PROOF MAP

## T 5 S R 1 W Sections 21, 28 and 33

### FESSLER FAMILY LLC. by Thomas Fessler

### Application S-85895 Permit S-54143

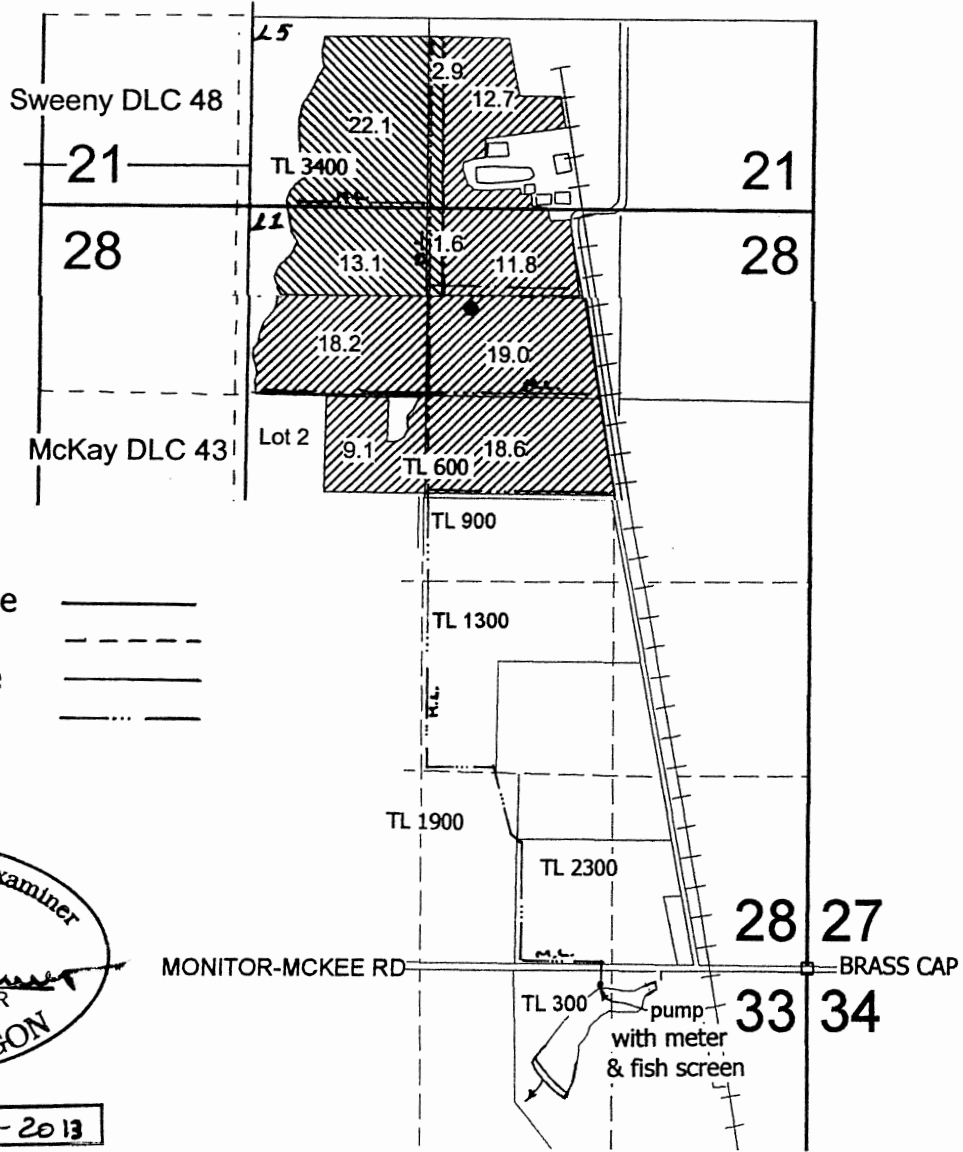

Section line —————  
 1/4 1/4 line - - - - -  
 tax lot line ————  
 pipe line —·—·—·—

Certified Water Rights Examiner  
 #75  
*Donald E. Knauer*  
 DONALD E. KNAUER  
 Nov. 19, 1987  
 STATE OF OREGON

RENEWAL DATE: 6-30-2013

Reservoir: 780' S & 1790' W of the NE corner Sec. 33  
 Pump with meter & fish screens: 130' S & 1410' W of the NE corner Sec. 33

4" = 1 mile



0 2500



This map is not intended to provide legal dimensions or locations of property ownership lines .

*Added gov lot #'s mfb/wrd 11-19-15*