

# FINAL PROOF MAP


IN THE NAME OF FESSLER FAMILY LLC

by Thomas Fessler

Application R-85380 Permit R-139521

Application S-85381 Permit S-54056


T 5 S, R 1 W, W.M. Section 28 & 33

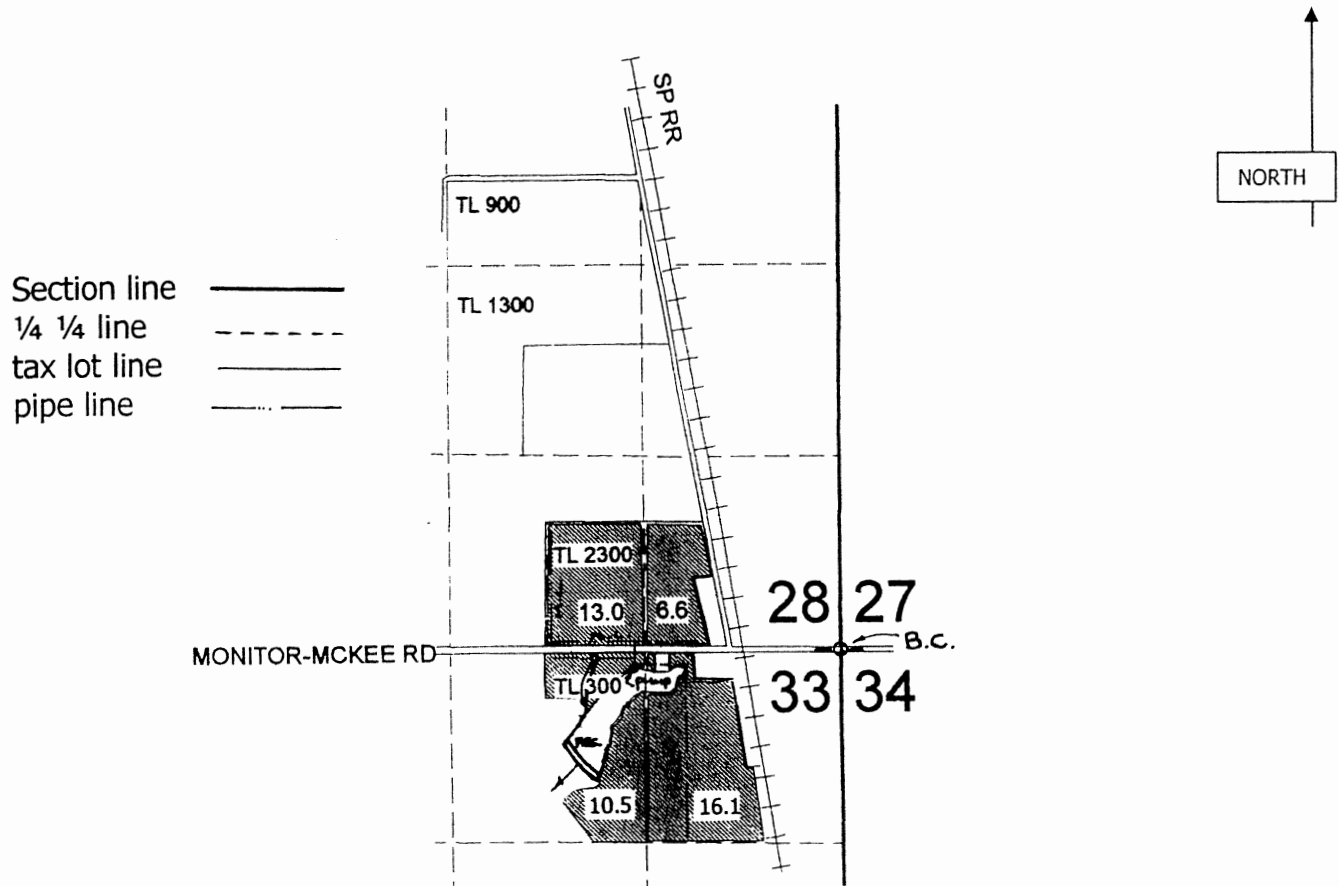

Reservoir: 780' S & 1790' W of the NE corner Sec. 33  
PUMP with meter & fish screens: 130' S & 1410' W of the NE corner Sec. 33

Scale 1" = 1320'

This map is not intended to provide legal dimensions or locations of property ownership lines .

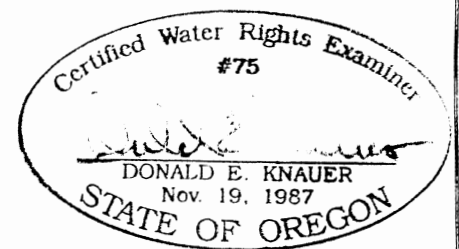

RENEWAL DATE: 6/30/2015

Updated Permit # R-13951. mfb/und 11-20-15