


FINAL PROOF MAP


IN THE NAME OF FESSLER FAMILY LLC
by Thomas Fessler
Application G-15893 Permit G-15606
T 5 S, R 1 W, W.M. Section 28 & 33

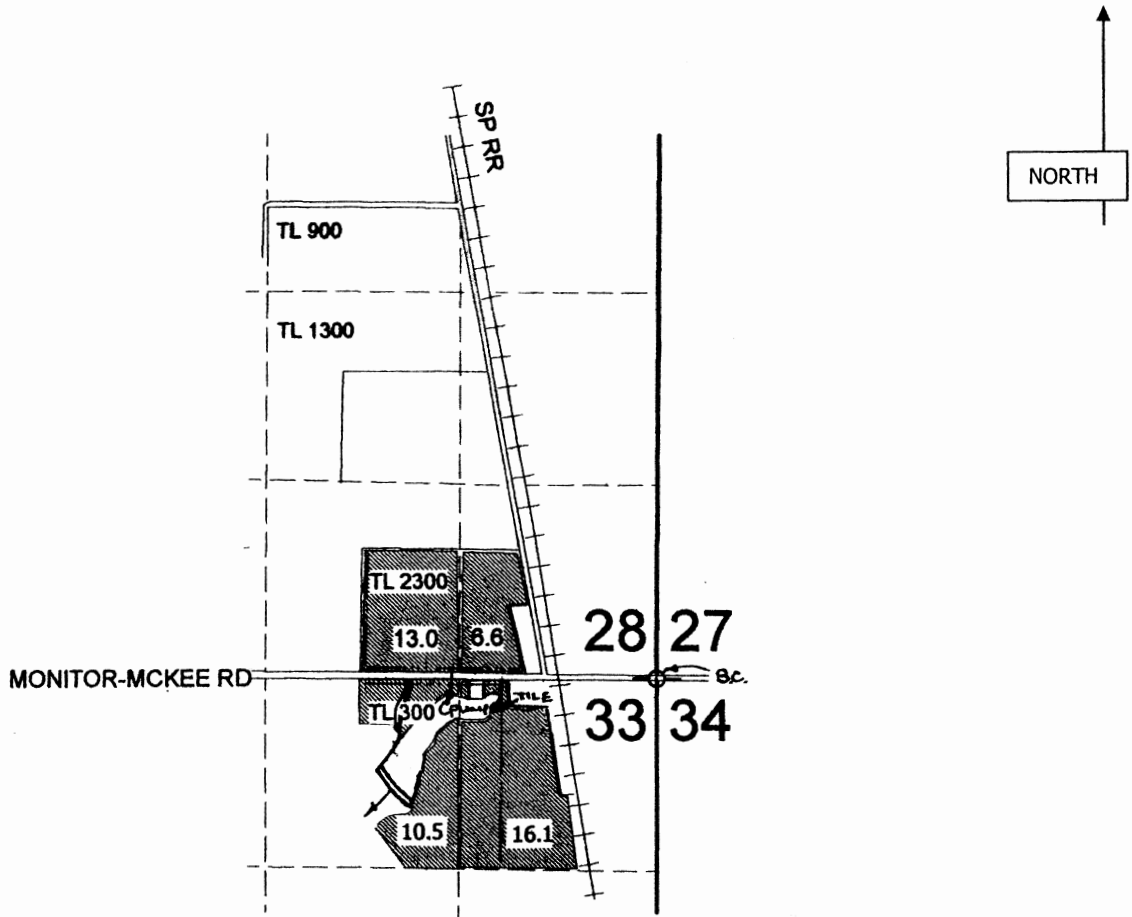

Drain Tile: 220' S & 1090' W of the NE corner Sec. 33
Pump with meter: 130' S & 1410' W of the NE corner Sec. 33

Scale 1" = 1320'

This map is not intended to provide legal dimensions or locations of property ownership lines .

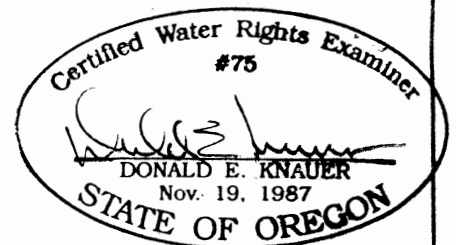

RENEWAL DATE: 6-30-2011