

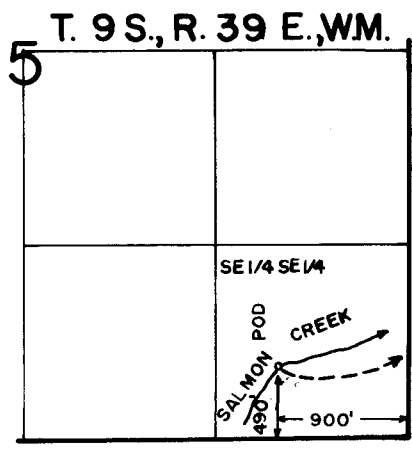
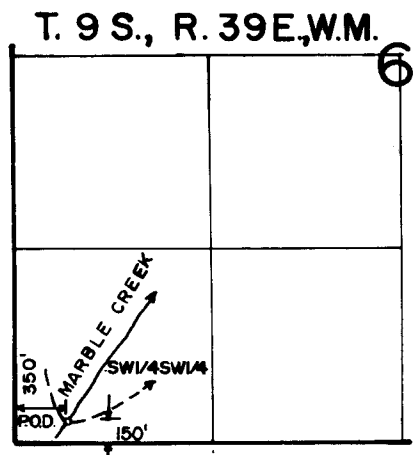


FINAL PROOF SURVEY

12-21-90 D.S.M.
41001-279-90R
41001-279-90L

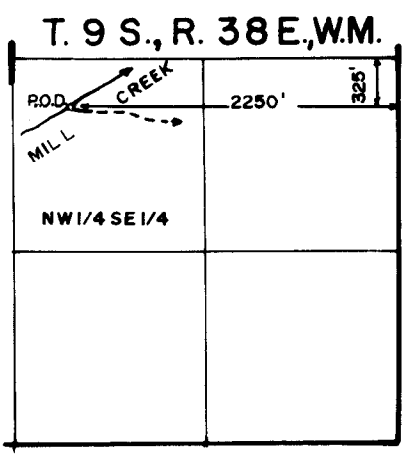

POCAHONTAS FARMERS DITCH

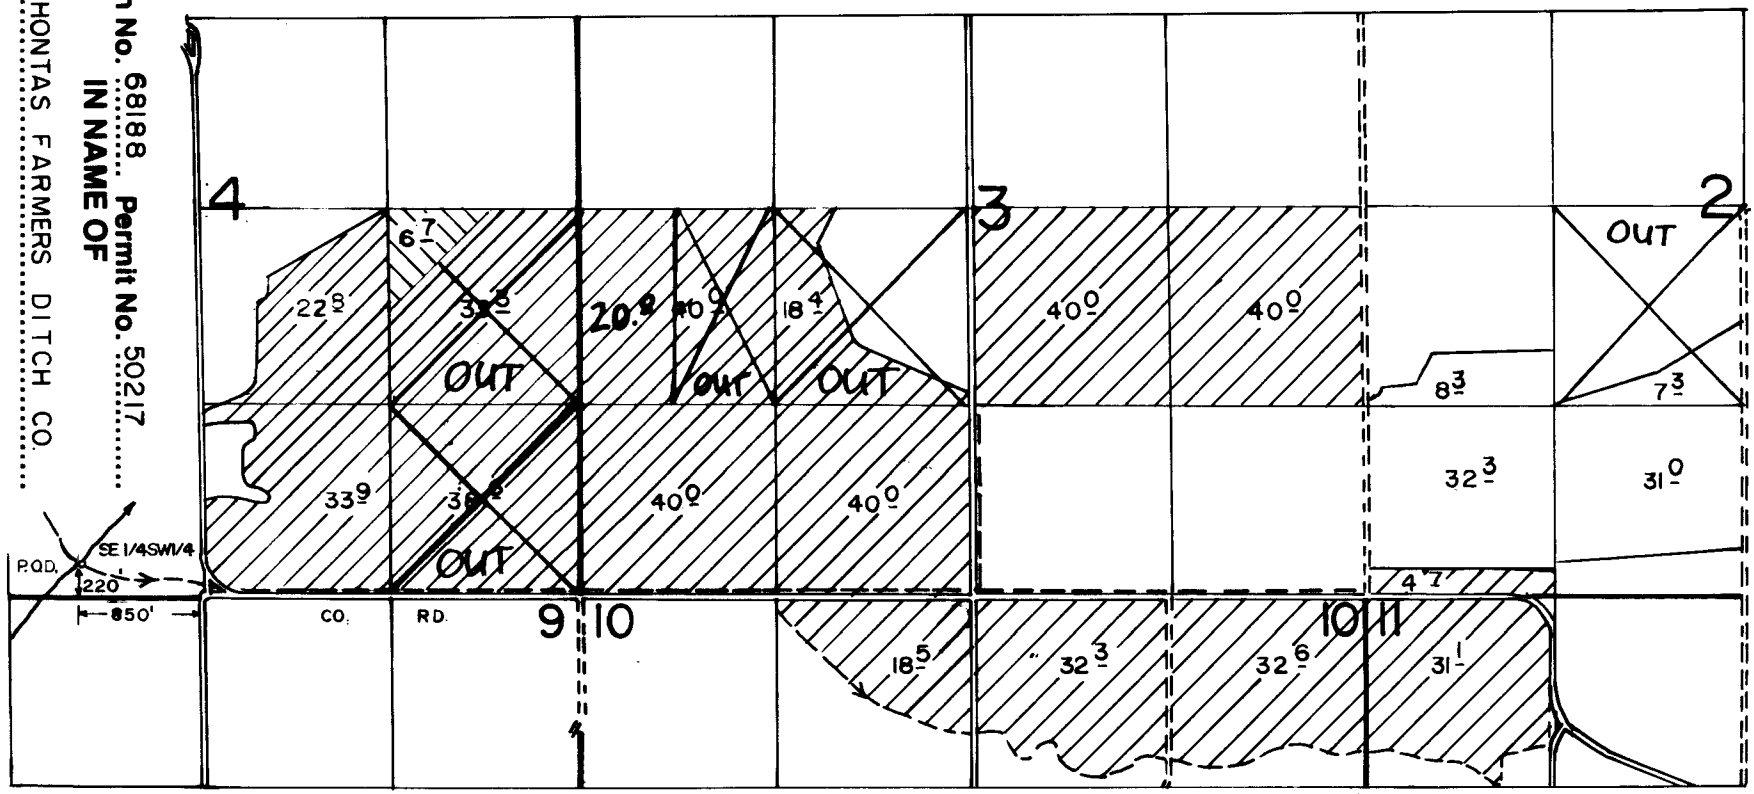

T. 9 S., R. 39 E., W.M.

Application No. 68188 Permit No. 50217
IN NAME OF

THE POCAHONTAS FARMERS DITCH CO.

Surveyed JUNE 5 1990, by V.L. CHURCH

* This map was updated to identify areas of irrigation both included and excluded. OWRD 05 11-9-15