



T. 7S., R. 39E., W.M.  
Section 32

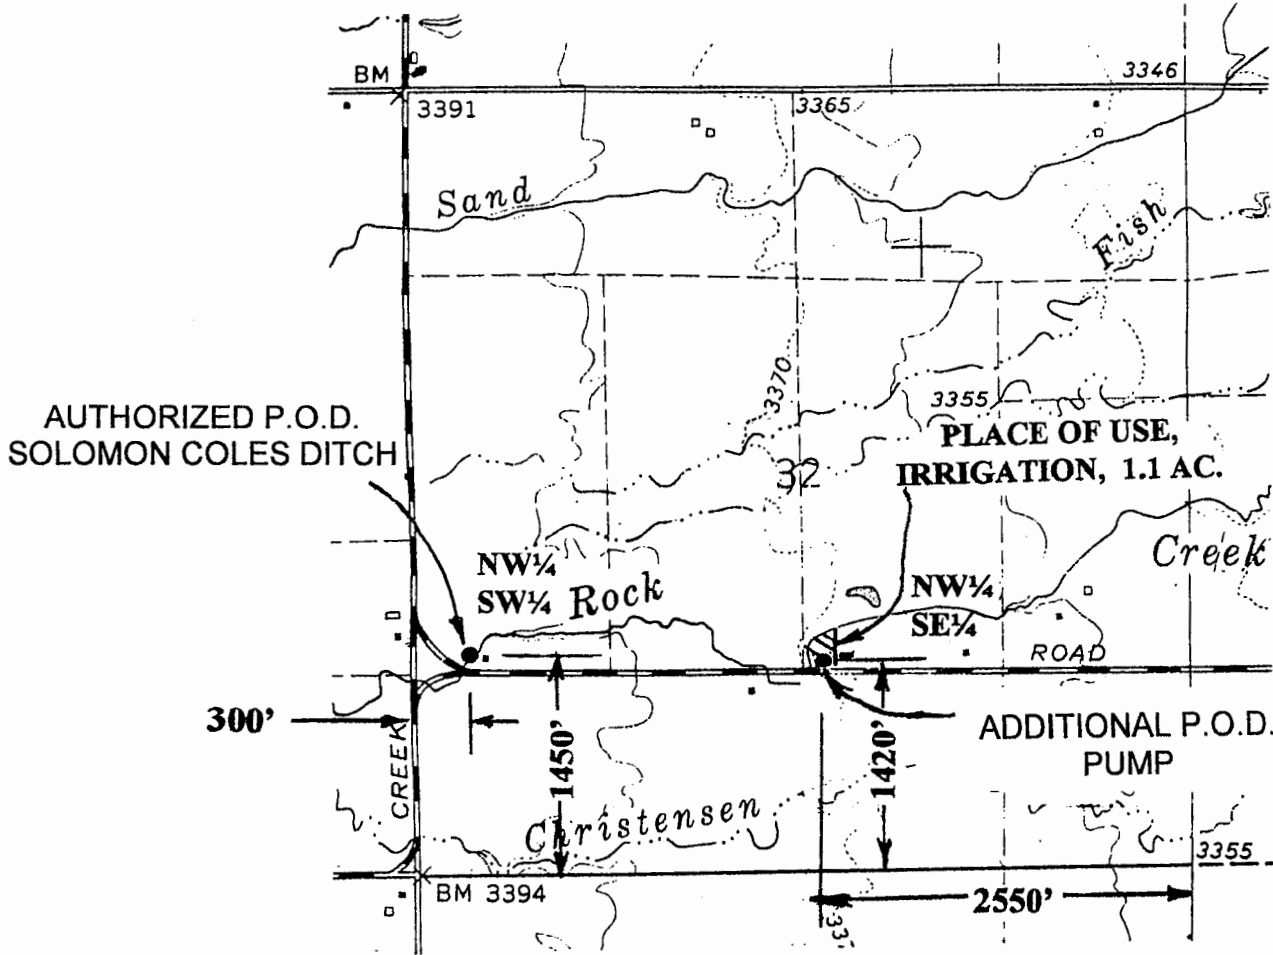

SCALE: 1" = 1320'

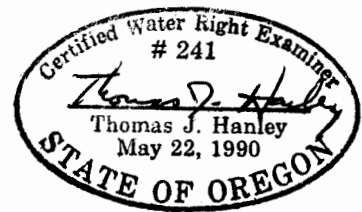

**FINAL PROOF SURVEY**  
**IN NAME OF**  
**Donald Phillips**  
Reference: T-8877  
Site Survey February 18, 2004  
by Hanley Engineering, Inc