


Remaining lands under Certificate 3922 now irrigated from Clear Water Ditch POD authorized by T-9715.

COBU MAP # 814



SCALE: 1"=1320'

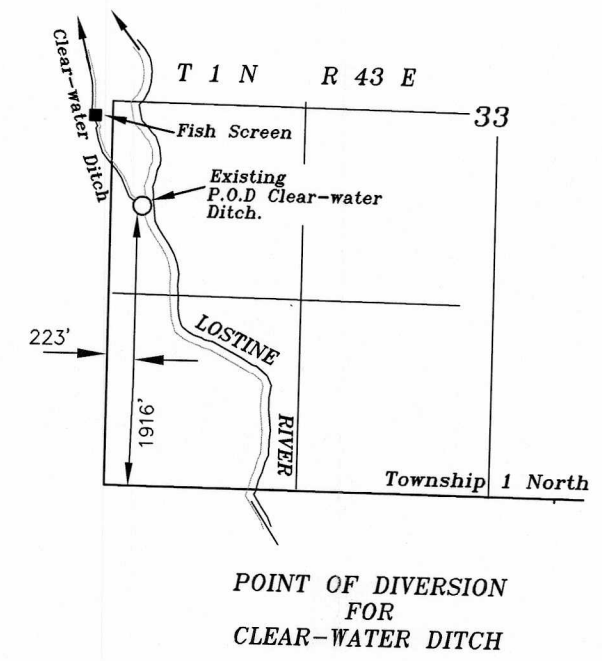


SCALE: 1"=1320'

NOTE: This map was drawn from a map of survey that correctly located the exterior positions of Section 30. The survey was completed for WALLOWA LAND TRUST to prepare a conservation easement. The Survey is filed with the Wallowa County Surveyor as CS 2009-013. You will note that the 40 lines are in excess of 1320 ft. in length.

RECEIVED BY OWRD  
MAR 03 2014  
SALEM, OR

February 10, 2014  
CLAIM OF BENEFICIAL USE MAP FOR  
A NEW POINT OF DIVERSION FROM CLEAR-WATER  
DITCH UNDER TRANSFER T-9715  
FOR  
WOODY WOLFE

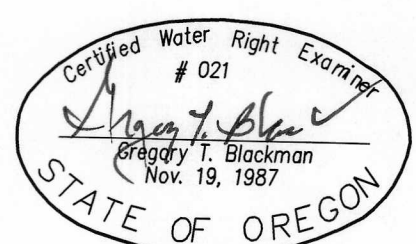

BY  
GREG BLACKMAN WATER RIGHTS  
126 RIDGE DRIVE  
LA GRANDE, OREGON 97850

NOTE: The preparation of this map was for the purpose of identifying the location of the proposed water right and has no intent to provide dimensions or location of property ownership lines. Location information shown hereon was furnished by the applicant.

APPLICATION NO. T-9715  
PERMIT NUMBER