


DESCHUTES COUNTY, OREGON

**T 14 S, R 12 E, WM
SECTION 20**

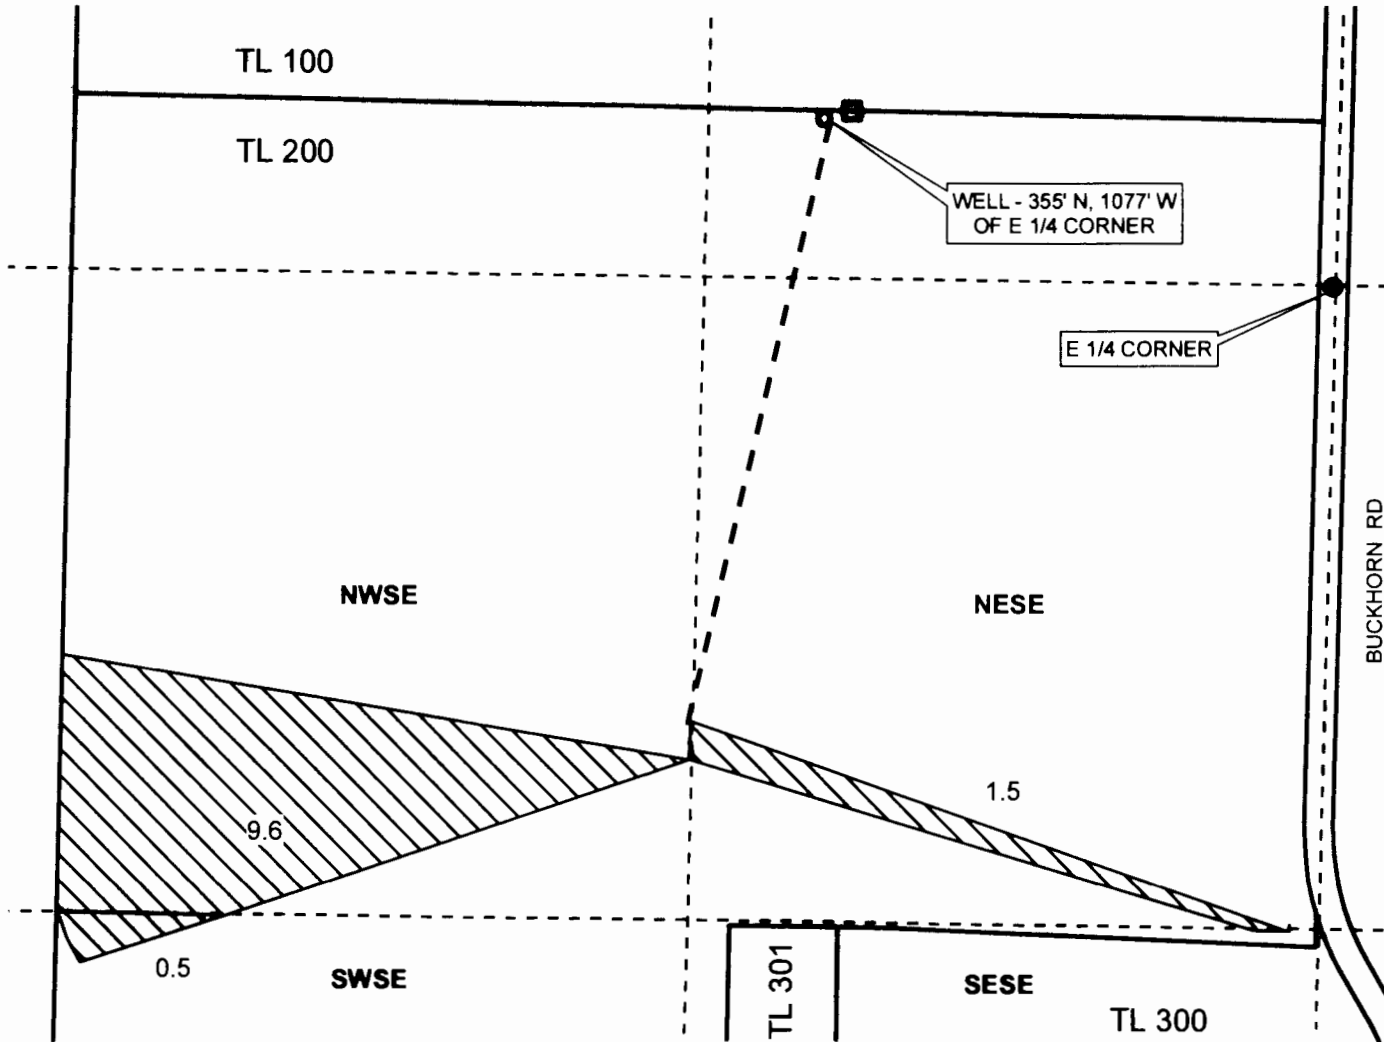


- METER
- BURIED PIPELINE
- POU IRRIGATION
- TAXLOT BOUNDARIES

RECEIVED BY OWRD

FEB 25 2016

SALEM OR

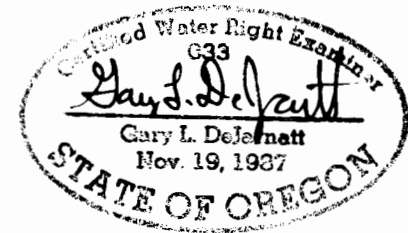

RENEWAL DATE 12-31-2017



**Claim of Beneficial Use Map for
TRANSFER T-11913 for GORHAM NICOL**

NOTE: THIS MAP IS NOT INTENDED TO
PROVIDE LEGAL DIMENSIONS OR LOCATIONS
OF PROPERTY OWNERSHIP LINES.

WATER RIGHT SERVICES, LLC
PO BOX 1830, BEND, OR 97709
WWW.OREGONWATER.US

PROJECT # 15073 SEPTEMBER 15, 2015

541-389-2837 JOHNSHORT@USA.COM