


T.4S. R.1W. Sec. 3 & 10, W.M.

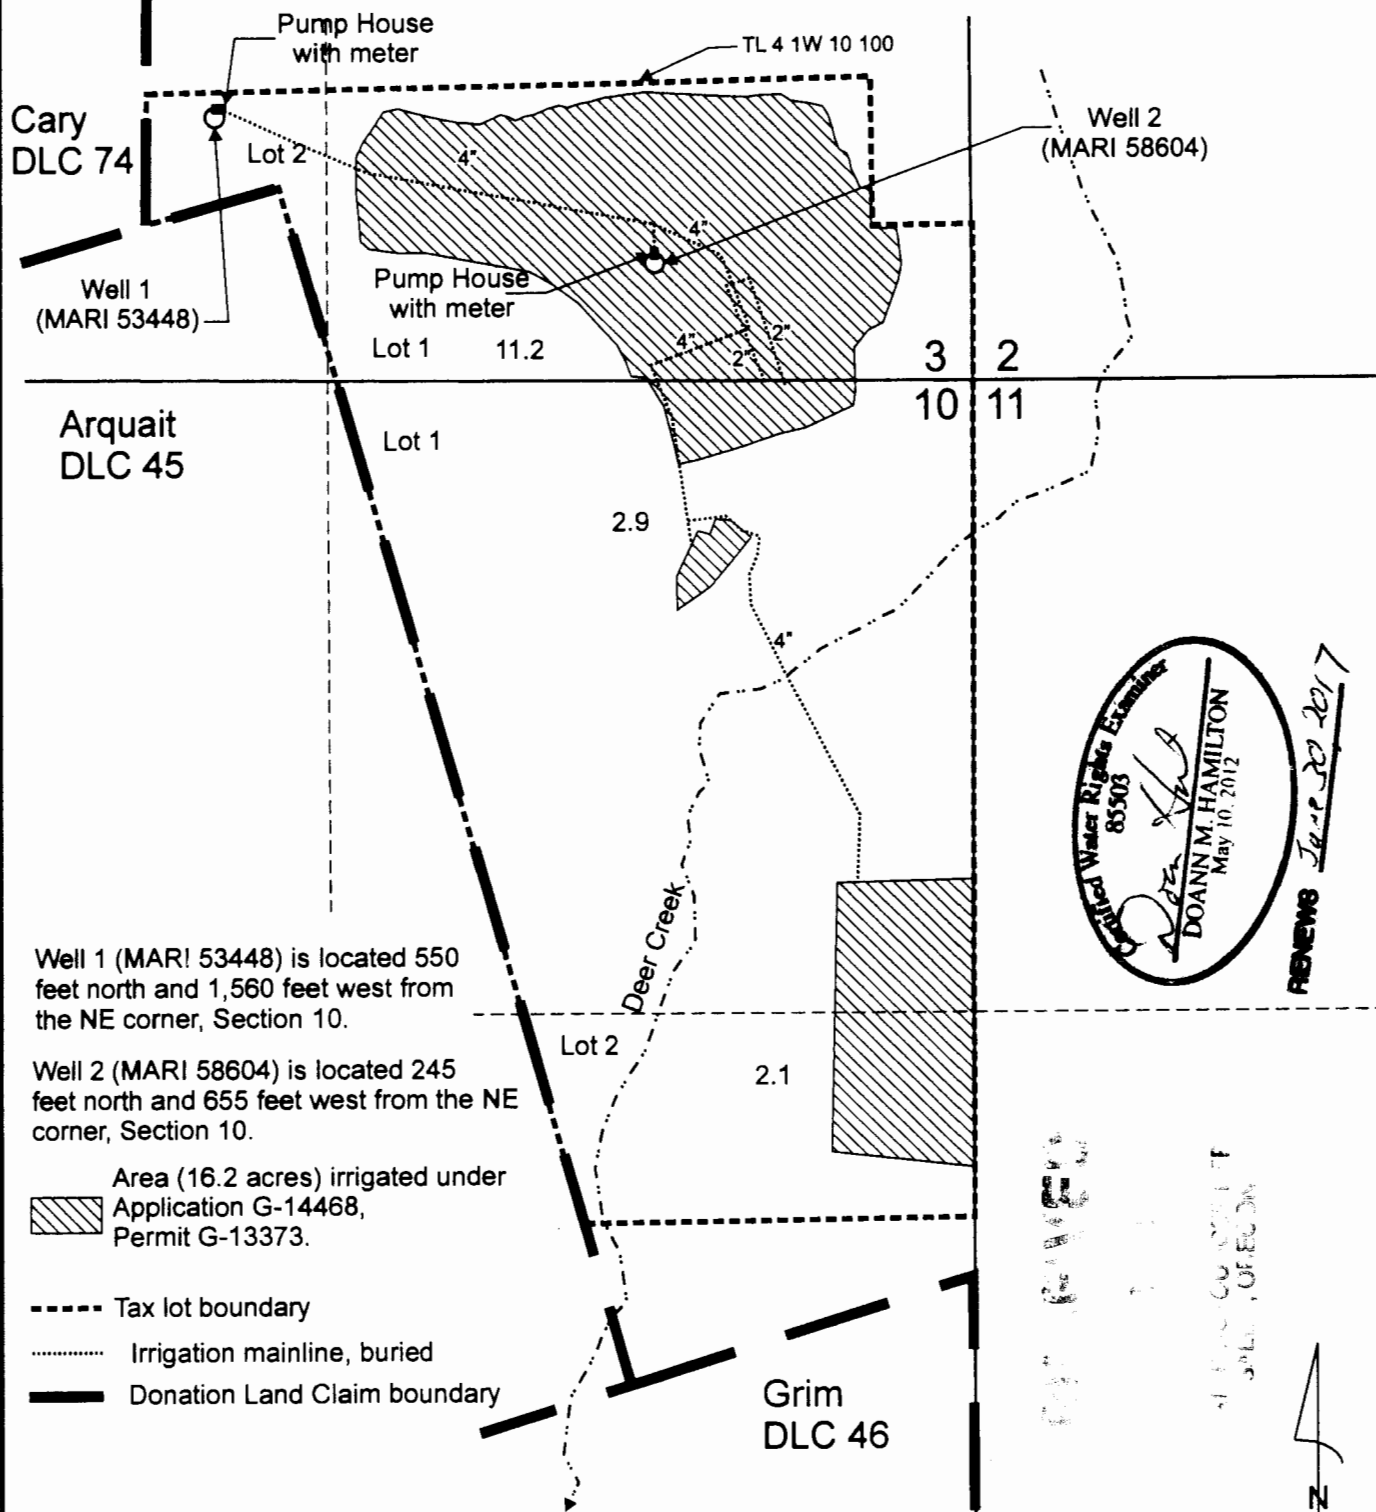


Well 1 (MARI 53448) is located 550 feet north and 1,560 feet west from the NE corner, Section 10.

Well 2 (MARI 58604) is located 245 feet north and 655 feet west from the NE corner, Section 10.

Area (16.2 acres) irrigated under Application G-14468, Permit G-13373.

- Tax lot boundary
- Irrigation mainline, buried
- Donation Land Claim boundary

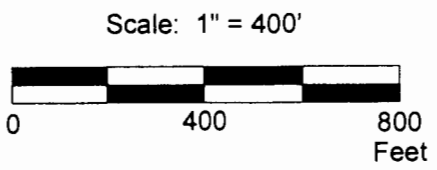

 85503
 DOANN M. HAMILTON
 May 10, 2012
 RENEWS June 20 2017

This map was prepared for the purpose of identifying the location of a water right only and is not intended to provide legal dimensions or location of property ownership lines.

Claim of Beneficial Use Map

Cedarwood Farm LLC
 T.4S. R.1W. Sec. 3 & 10, W.M.

Pacific Hydro-Geology Inc.

08/2015

Portland Cedarwood COBU.cdr