



CLAIM OF BENEFICIAL USE MAP
 APPLICATION S-87808 - PERMIT S-54796
 SECTIONS 7 & 18
 TOWNSHIP 36 SOUTH, RANGE 3 WEST, W.M.
 JACKSON COUNTY, OREGON
 FOR
 DEL RIO VINEYARDS, LLC
 P.O. BOX 906
 GOLD HILL, OR 97525

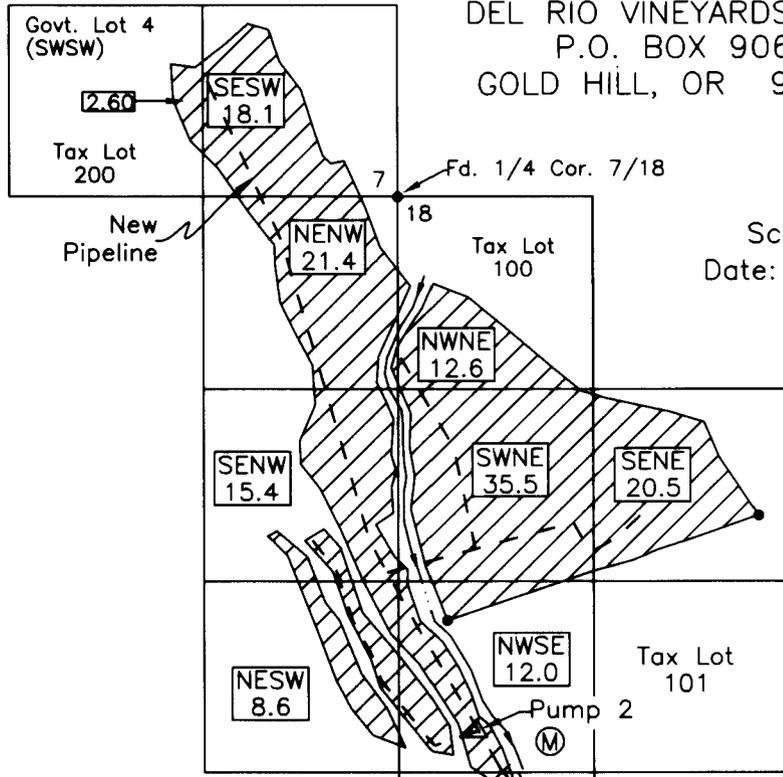

Scale: 1"=1320'
 Date: August 4, 2015

LEGEND

- Found Corner
- Denotes Building or Structure
- Denotes Tax Lot Line
- - - Denotes Buried Pipeline
- ▨ Denotes Place of Use
- Ⓜ Denotes Flow Meter
- △ Denotes Pump Location

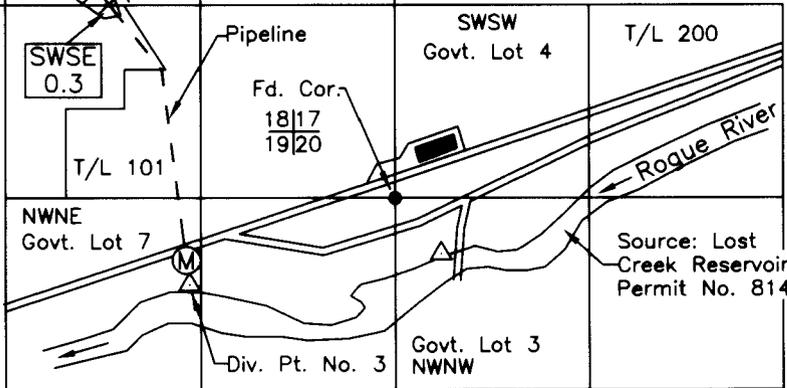

Source: Lost Creek Reservoir
 Permit No. 8142.
 Fish Screen at Point of Diversion

Diversion Pt. No. 3: NW1/4NE1/4,
 Sec. 19, T36S, R3W, W.M.; 760'
 South & 1390' West from SW
 Cor., Sec. 17

This map was prepared for the
 purpose of identifying the location
 of a water right only and is not
 intended to provide legal dimen-
 sions or location of property
 ownership.

HAROLD L. CENTER
 2604 David Lane
 Medford, OR. 97504
 Phone 541-535-6108
 Oregon Certificate No. 152
 Cert. Renewal Date: 12/31/2015



RECEIVED BY OWRD