

APPLICATION G 16514
 PERMIT G16125
 AMENDMENT T11213

COORDINATES
 WELL 2: N427117.4, E5108315.8
 WELL 3: N427098.4, E5108433.3
 COORDINATES BASED ON WGS84 DATUM USED BY GOOGLE EARTH,
 TRANSFORMED TO NAD83, ZONE 10

DISTANCE (FEET) FROM NE CORNER OF SECTION 5:
 WELL 2: 720' S, 400' W
 WELL 3: 358' S, 475' W

LEGEND

- ◆ WELL 2 POINT OF APPROPRIATION
- TAX LOT 2700 BOUNDARY
- SECTION LINES
- DLC BOUNDARIES

RECEIVED
 MAR 20
 WRD




EXPIRES: 12-31-16

Kennedy/Jenks Consultants

NOTES:

1. THIS MAP IS NOT INTENDED TO PROVIDE LEGAL DIMENSIONS OR LOCATIONS OF PROPERTY OWNERSHIP LINES.
2. TOTALIZING FLOW METERS ARE LOCATED AT THE WELLHEAD OF WELL 2 AND WELL 3.
3. SEE ATTACHED PLACE OF USE LIST
4. BASE MAP SOURCE: CLATSOP COUNTY WEBMAPS

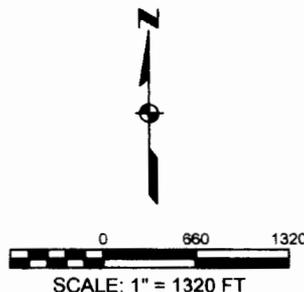

OREGON MILITARY DEPARTMENT
 CAMP RILEA

CLAIM OF BENEFICIAL USE MAP

K/J 1496214.00
 JULY 2015

FIGURE 1

2/25/2016 5:30 PM

ALICE ROBINSON

I:\P\2\C\card\1411496214_00_0MD\149621400-FIGURE_1_updated.dwg