


Township 1 South
12E

1851
Range

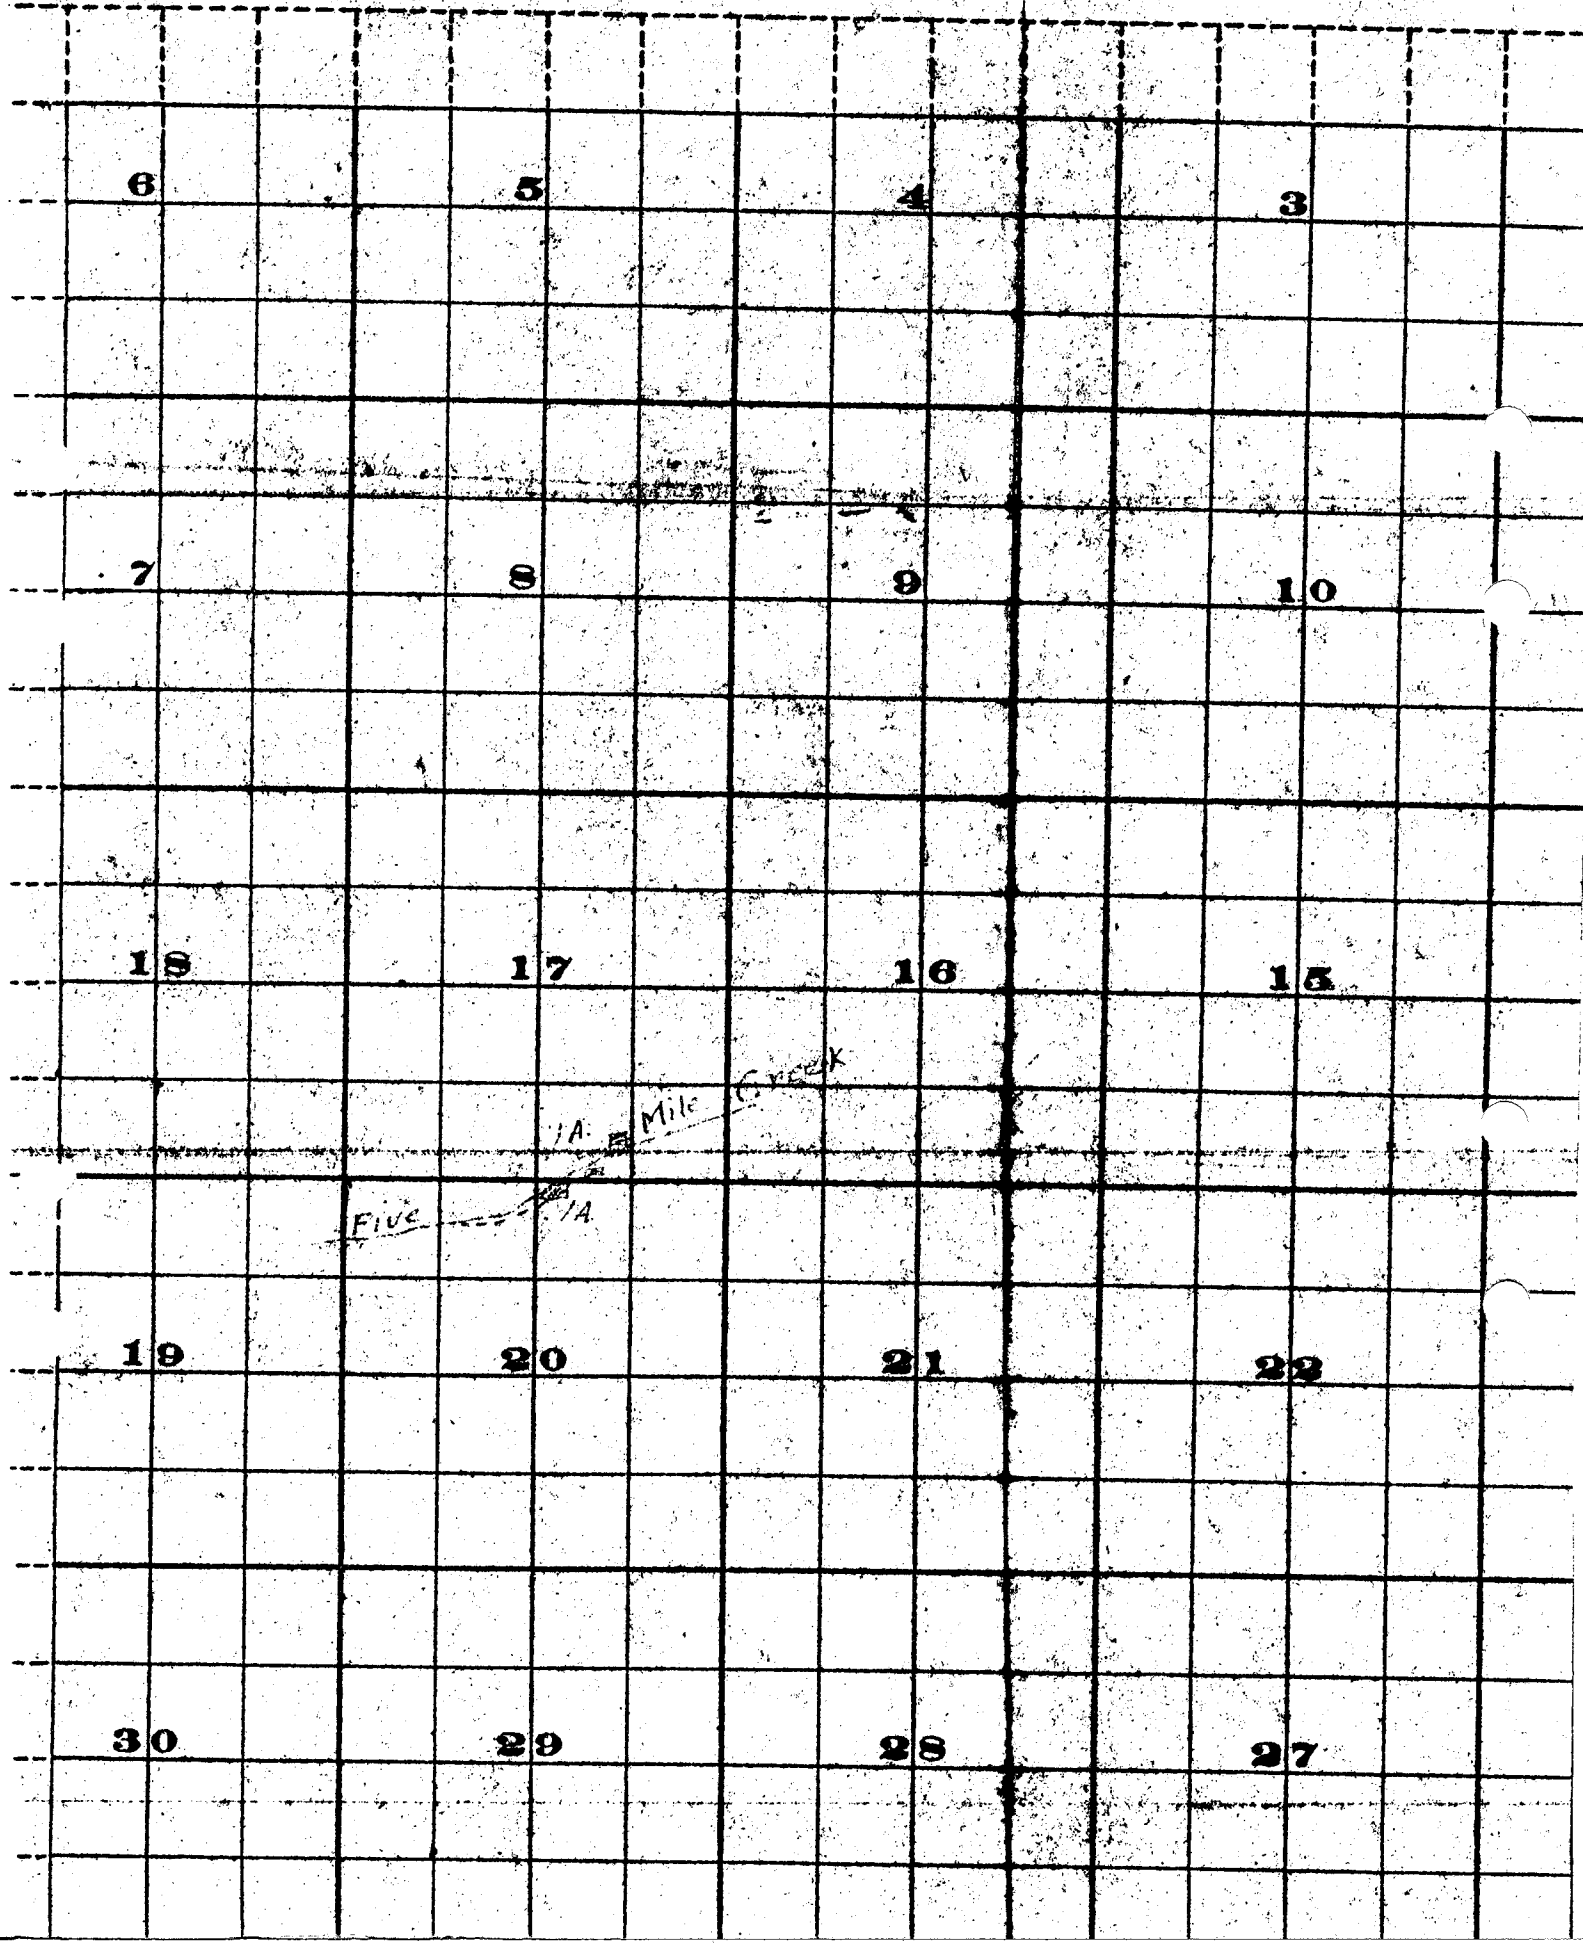

6

5

4

3

7

8

9

10

18

17

16

15

19

20

21

22

30

29

28

27

1A Mile Creek

FIVE 1A