


NW 1/4 of NE 1/4 SECTION 27  
 SW 1/4 of NE 1/4 SECTION 27  
 NW 1/4 of SE 1/4 SECTION 27  
 SE 1/4 of NW 1/4 SECTION 27  
 T3S, R4E of the WM  
 CLACKAMAS COUNTY, OREGON

| SEC. | 1/4 1/4 | IRRIGATED ACRES    | CFS (GPM)           |
|------|---------|--------------------|---------------------|
| 22   | SW SE   | 6.72 ACRES         | 0.1680 CFS (75 GPM) |
| 27   | NW NE   | 2.78 ACRES         | 0.0695 CFS (31 GPM) |
| 27   | SW NE   | 2.75 ACRES         | 0.0688 CFS (31 GPM) |
| 27   | NW SE   | 10.5 ACRES         | 0.2625 CFS (118GPM) |
| 27   | NW SE   | 10.0 ACRES         | 0.0700 CFS (31 GPM) |
|      | TOTAL   | 22.75 ACRES IRRIG. | 0.668CFS (300GPM)   |




SCALE 1"=1320'

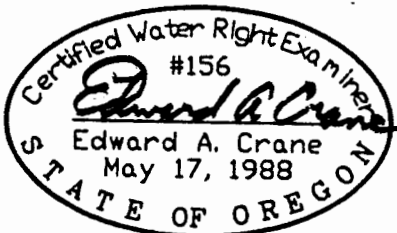

Renewal 12/31/2003  
 Signed 5-7-2003

SURVEYED APRIL 8, 2003.  
 BY EDWARD A. CRANE, CWRE

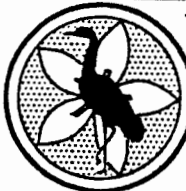

**CRANE & MERSETH**  
 Engineering/Surveying  
 SUITE 'D'  
 6566 SE LAKE ROAD  
 MILWAUKIE, OREGON 97222  
 BUS: (503) 654-2005  
 FAX: (503) 654-2575

DATE  
 MAY 2003  
 PROJECT NO.  
 455-001

PREPARATION OF THIS MAP WAS FOR THE PURPOSE  
 OF IDENTIFYING THE LOCATION OF THE WATER RIGHTS  
 ONLY AND HAS NO INTENT TO PROVIDE DIMENSIONS  
 OR LOCATION OF PROPERTY OWNERSHIP LINES.

**FINAL PROOF SURVEY FOR  
 GROUNDWATER PERMIT G-15207**

APPLICATION FOR PERMIT NUMBER G-15313  
 PERMIT NUMBER G-15207 IN THE NAME OF:  
 BEN J. FRANKLIN & LISA MARIE HOPKINS  
 BEN FRANKLIN NURSERY (TEL: 503-630-6627)  
 35674 SE SQUAW MTN RD, ESTACADA, OREGON

SHEET  
 1/1

NORTH FORK  
 WADE CREEK  
 TO CLACKAMAS  
 RIVER

W 1/4

C 1/4

E 1/4

SE LAWRENCE RD

SE CURRIN RD

CURRIN CREEK

SW COR  
 DLC #63

SE COR  
 DLC #63  
 G.W. PALMATEER

SW COR  
 DLC #63

TL 700  
 ZONED R.R.F.F.-5  
 51.62AC GROSS  
 10.00AC IRRIG  
 (2AC BLUEBERRIES)  
 (10.00AC IN-GRD)

SE COR  
 DLC #63

SE COUPLAND RD (#792)

CREEK

WELL #1

TL 700

TL 100

TL 205

TL 203

TL 201

TL 204

TL 207

TL 206

RESERVOIR #1

RESERVOIR #2

EXCAVATED  
 SIDEHILL  
 POND

WELL #3

112GPM, 3HP

1-1/2' PVC

TL 211

7.10AC

SE SQUAW MTN RD

1-1/2' PVC

WELL #2

112GPM, 3HP

RESERVOIR #1

RESERVOIR #2

RESERVOIR #3

TL 2700 C 1/4  
 ZONED R.R.F.F.-5  
 24.50AC GROSS  
 10.00AC IRRIG



RESERVOIR #5

RESERVOIR #4

LINGLEBECK CREEK INTAKE

LINGLEBECK  
 CREEK

ESTACADA 7.5 MIN. QUAD  
 ASSESSOR MAP 22 4E 3S INDEX

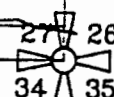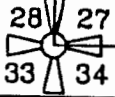

IRRIG. WELL #1 IS LOCATED 300 FEET NORTH AND 1880 FEET WEST  
 OF THE SOUTHEAST CORNER OF SEC. 22, T.3 S., R.4 E. of the WM  
 IRRIG. WELL #2 IS LOCATED 95 FEET SOUTH AND 655 FEET EAST  
 OF THE CENTER 1/4 CORNER OF SEC. 27, T. 3 S., R.4 E. of the WM  
 IRRIG. WELL #3 IS LOCATED 950 FEET NORTH AND 600 FEET EAST  
 OF THE CENTER 1/4 CORNER OF SEC. 27, T. 3 S., R.4 E. of the WM