


NW 1/4 of NE 1/4 SECTION 27
 SW 1/4 of NE 1/4 SECTION 27
 NW 1/4 of SE 1/4 SECTION 27
 SE 1/4 of NW 1/4 SECTION 27
 T3S, R4E of the WM
 CLACKAMAS COUNTY, OREGON

NORTH FORK
 WADE CREEK
 TO CLACKAMAS
 RIVER

SEC.	1/4	1/4	IRRIGATED ACRES	CFS (GPM)
22	SW	SE	6.72 ACRES	0.1680 CFS (75 GPM)
27	NW	NE	2.78 ACRES	0.0695 CFS (31 GPM)
27	SW	NE	2.75 ACRES	0.0688 CFS (31 GPM)
27	NW	SE	10.5 ACRES	0.2625 CFS (118 GPM)
27	NW	SE	10.0 ACRES	0.0700 CFS (31 GPM)
	TOTAL		22.75 ACRES IRRIG.	0.668 CFS (300 GPM)




SCALE 1"=1320'

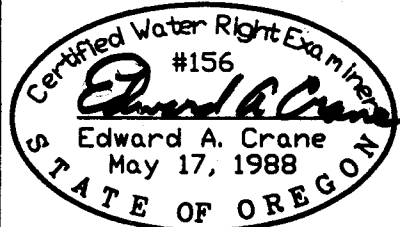

Renewal 12/31/2003

Signed *Edward A. Crane*

SURVEYED APRIL 8, 2003.
 BY EDWARD A. CRANE, CWRE

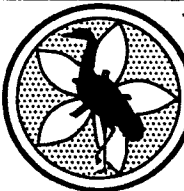

CRANE & MERSETH
 Engineering/Surveying
 SUITE 'D'
 6566 SE LAKE ROAD
 MILWAUKIE, OREGON 97222
 BUS: (503) 654-2005
 FAX: (503) 654-2575

DATE
 MAY 2003
 PROJECT NO.
 455-001

PREPARATION OF THIS MAP WAS FOR THE PURPOSE
 OF IDENTIFYING THE LOCATION OF THE WATER RIGHTS
 ONLY AND HAS NO INTENT TO PROVIDE DIMENSIONS
 OR LOCATION OF PROPERTY OWNERSHIP LINES.

**FINAL PROOF SURVEY FOR
 GROUNDWATER PERMIT G-15207**

APPLICATION FOR PERMIT NUMBER G-15313
 PERMIT NUMBER G-15207 IN THE NAME OF:
 BEN J. FRANKLIN & LISA MARIE HOPKINS
 BEN FRANKLIN NURSERY (TEL: 503-630-6627)
 35674 SE SQUAW MTN RD, ESTACADA, OREGON

SHEET
 1/1

