

MAP TO ACCOMPANY CLAIM OF BENEFICIAL USE


SECTIONS 17, 18, 19, 20, 21, 28 & 29
TOWNSHIP 35 SOUTH, RANGE 21 EAST, W.M.
LAKE COUNTY, OREGON

APPLICATION NO. R-70484
PERMIT NO. R-11347



SCALE 1"=1320'

CHEWAUCAN RIVER

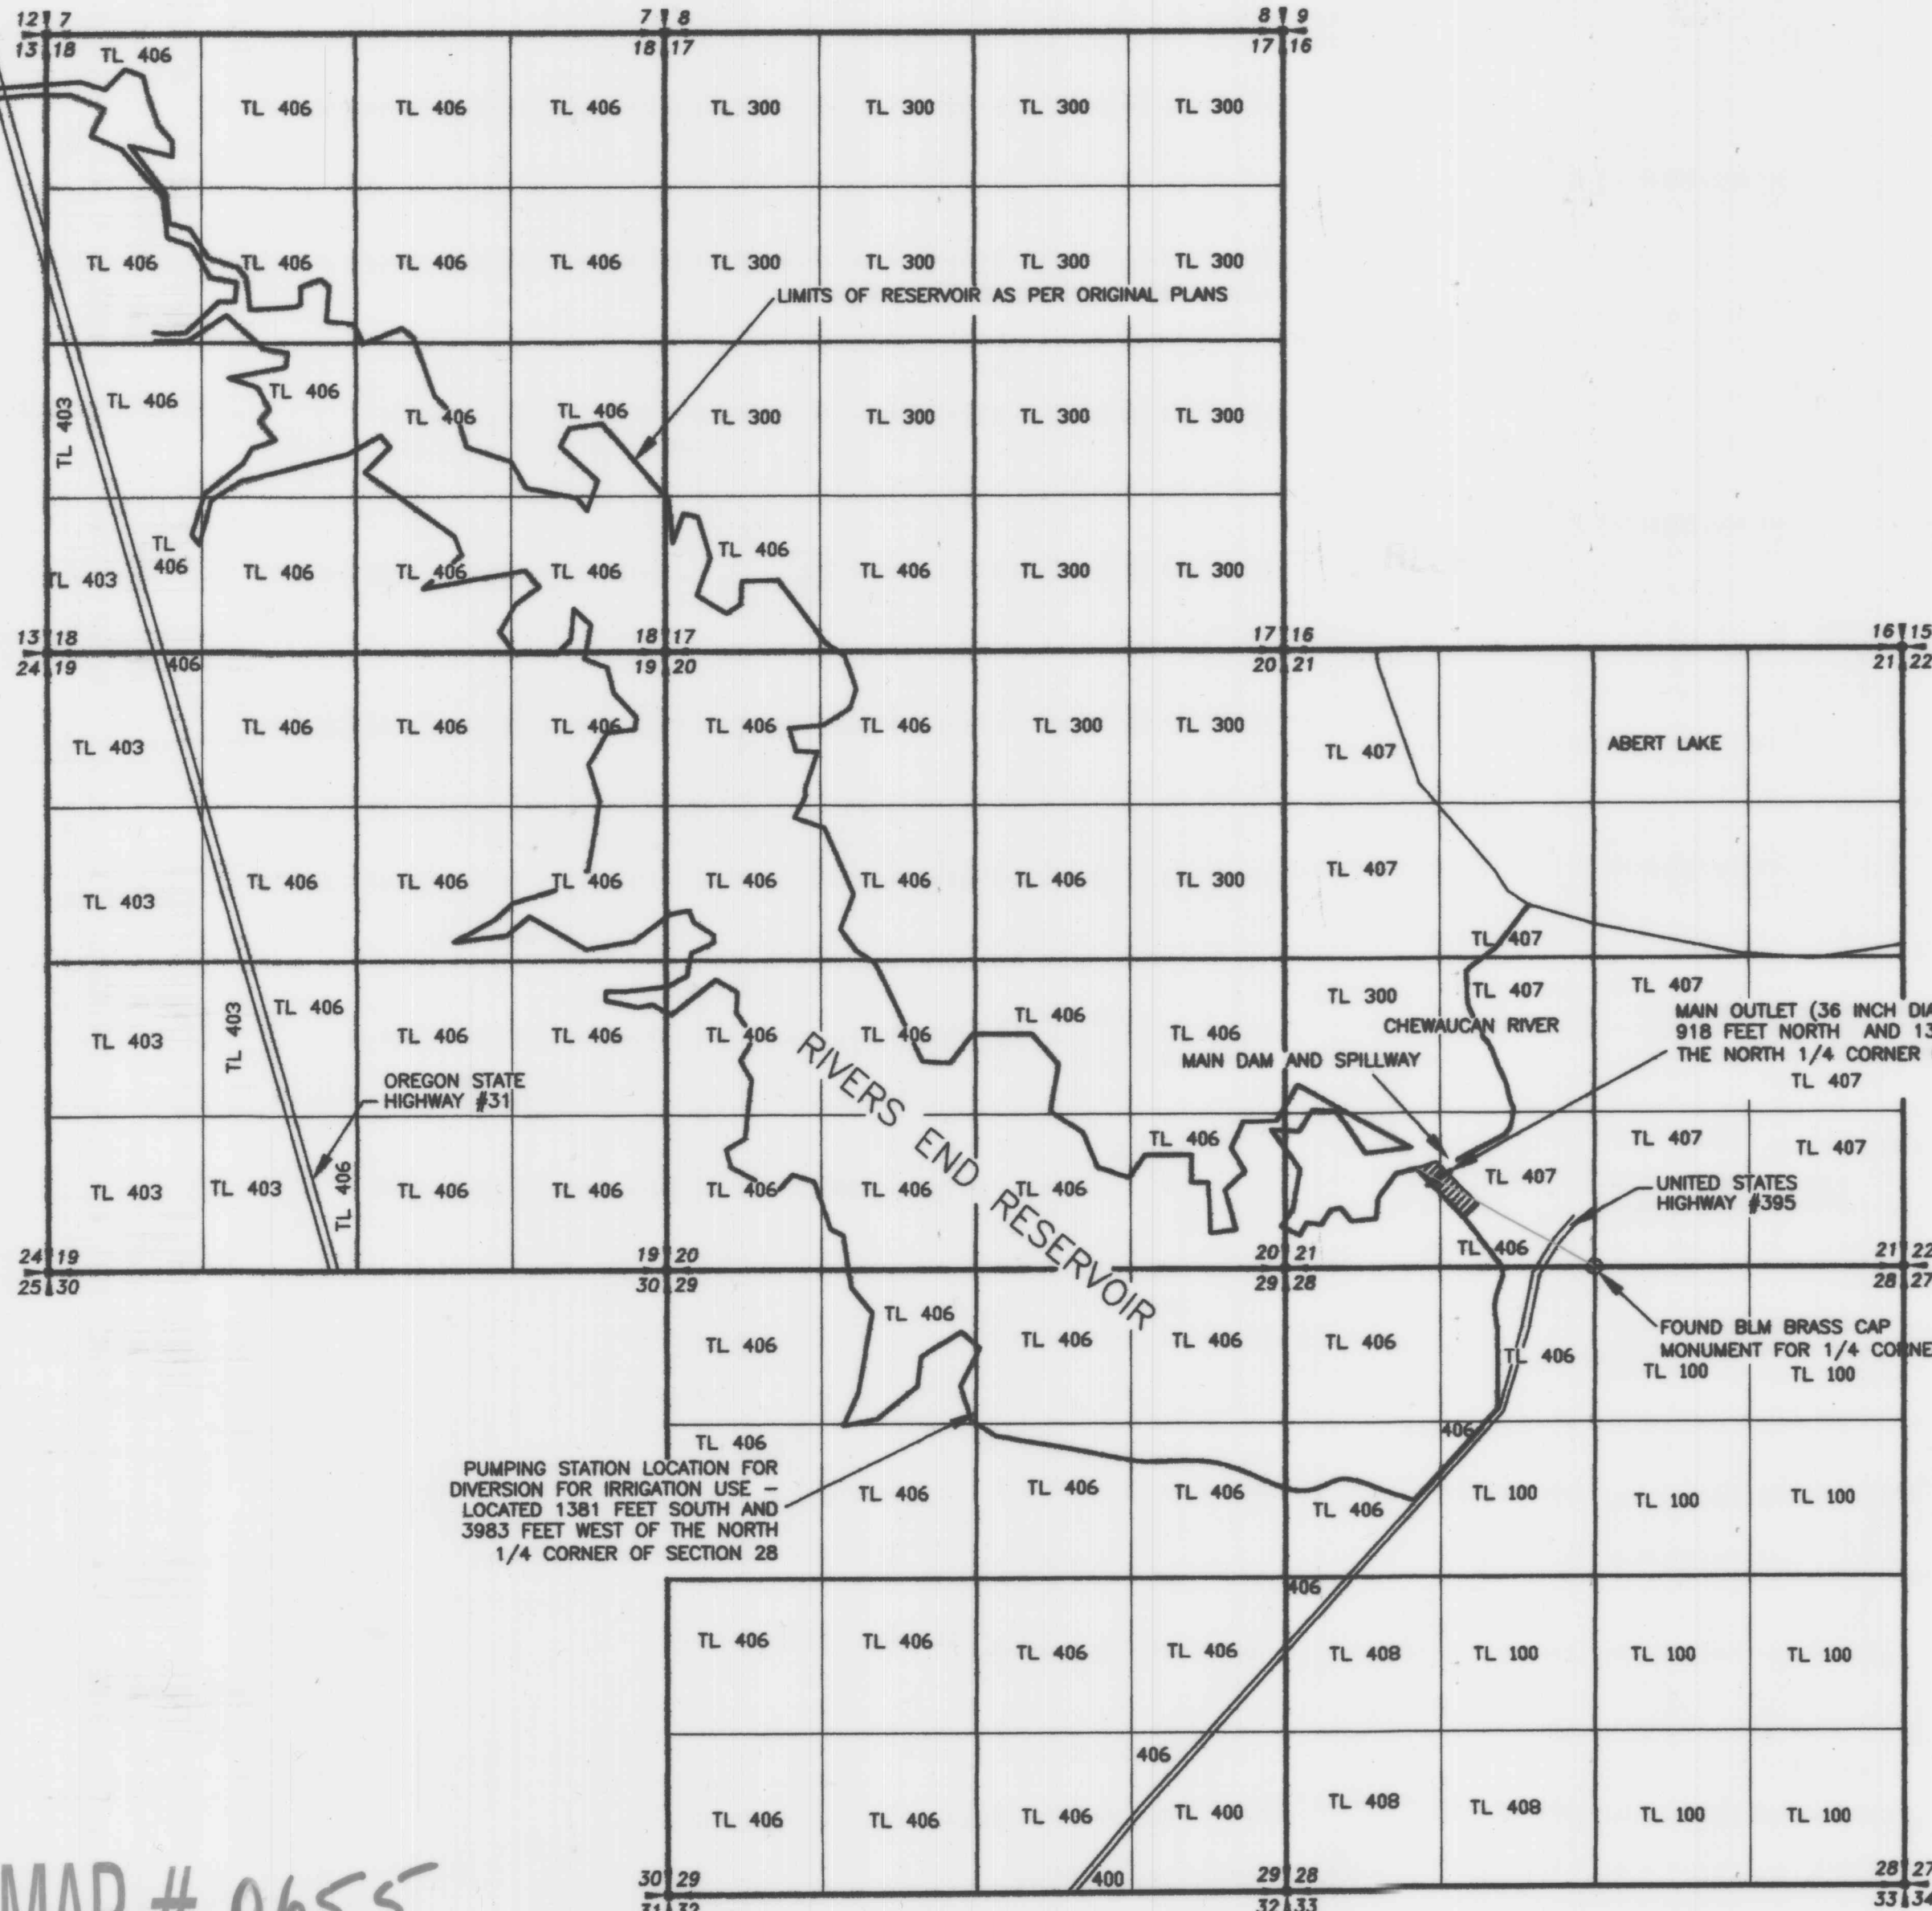


SPILLWAY CREST OF RESERVOIR AT ELEVATION 4280
RESERVOIR CAPACITY 1839 ACRE-FEET
RESERVOIR AREA (FULL) 650 ACRES

CREST ELEVATION VERIFIED IN FIELD
CAPACITY AND AREA AS PER CONSTRUCTION PLANS

RECEIVED
FEB 10 2012
WATER RESOURCES DEPT
SALEM, OREGON

LEGEND
— SECTION LINE
— 1/4 SECTION LINE
— 1/16 SECTION LINE

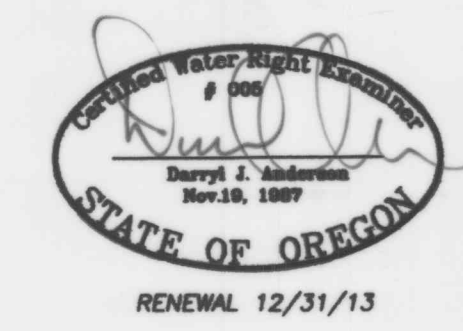


NOTE: PREPARATION OF THIS MAP IS FOR IDENTIFYING PROPOSED WATER RIGHTS ONLY. IT HAS NO INTENT TO PROVIDE LOCATIONS OR DIMENSIONS OF PROPERTY BOUNDARIES.

COBU MAP # 0655

PREPARED FOR:
WAYNE CLARK
68 LEVERONI COURT SUITE 200
NOVATO, CA 94949

PREPARED BY:
ANDERSON ENGINEERING & SURVEYING, INC.


 P.O. BOX 28
LAKEVIEW, OREGON 97630
(541) 947-4407
FAX 947-2321

DATE: SEPT 2011 DWG. FILE: 2009-081
JOB NO.: 2009-081 SHEET 1 OF 1

REVISIONS	BY

MAP TO ACCOMPANY
AREA-CAPACITY CURVE
FOR
RIVERS END RESERVOIR
WAYNE CLARK

SECTION 13
TOWNSHIP 35 SOUTH RANGE 20 EAST, W.M.
&
SECTIONS 17, 18, 19, 20, 21, 28 & 29
TOWNSHIP 35 SOUTH RANGE 21 EAST, W.M.
LAKE COUNTY, OREGON

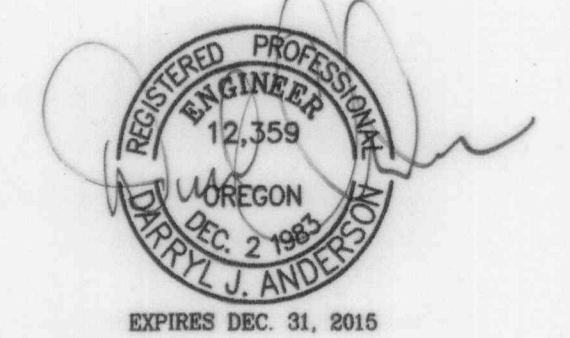

■ SUBMERGED AREA

APPLICATION NO. R-70484
PERMIT NO. R-11347

NOTE:
CONTOURS AT 1' INTERVAL



PREPARATION OF THIS MAP IS FOR IDENTIFYING PROPOSED
WATER RIGHTS ONLY. IT HAS NO INTENT TO PROVIDE
LOCATIONS OR DIMENSIONS OF PROPERTY BOUNDARIES.

ANDERSON ENGINEERING
AND SURVEYING, INC.
P.O. BOX 28
LAKEVIEW, OREGON 97630
(503) 947-4407 / FAX 947-2821
WWW.ANDERSONENGINEERING.COM

PREPARED FOR:
RIVERS END RANCH
WAYNE CLARK
68 LEVERONI COURT SUITE 200
NOVATO, CA 94949

RIVERS END RESERVOIR TOPOGRAPHY
SECTION 13, T35S, R20E, W.M.
SECTIONS 17, 18, 19, 20, 21, 28 & 29, T35S, R21E, W.M.
VALLEY FALLS, OREGON

DATE: 8/26/2015
SCALE: 1" = 600'
DWG. BY: R.C.
FILE: 2015-088
JOB NO.: 2015-088
SHEET

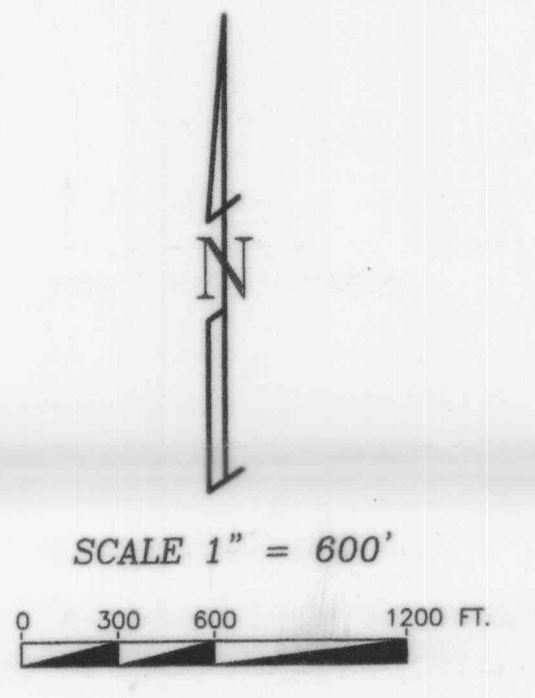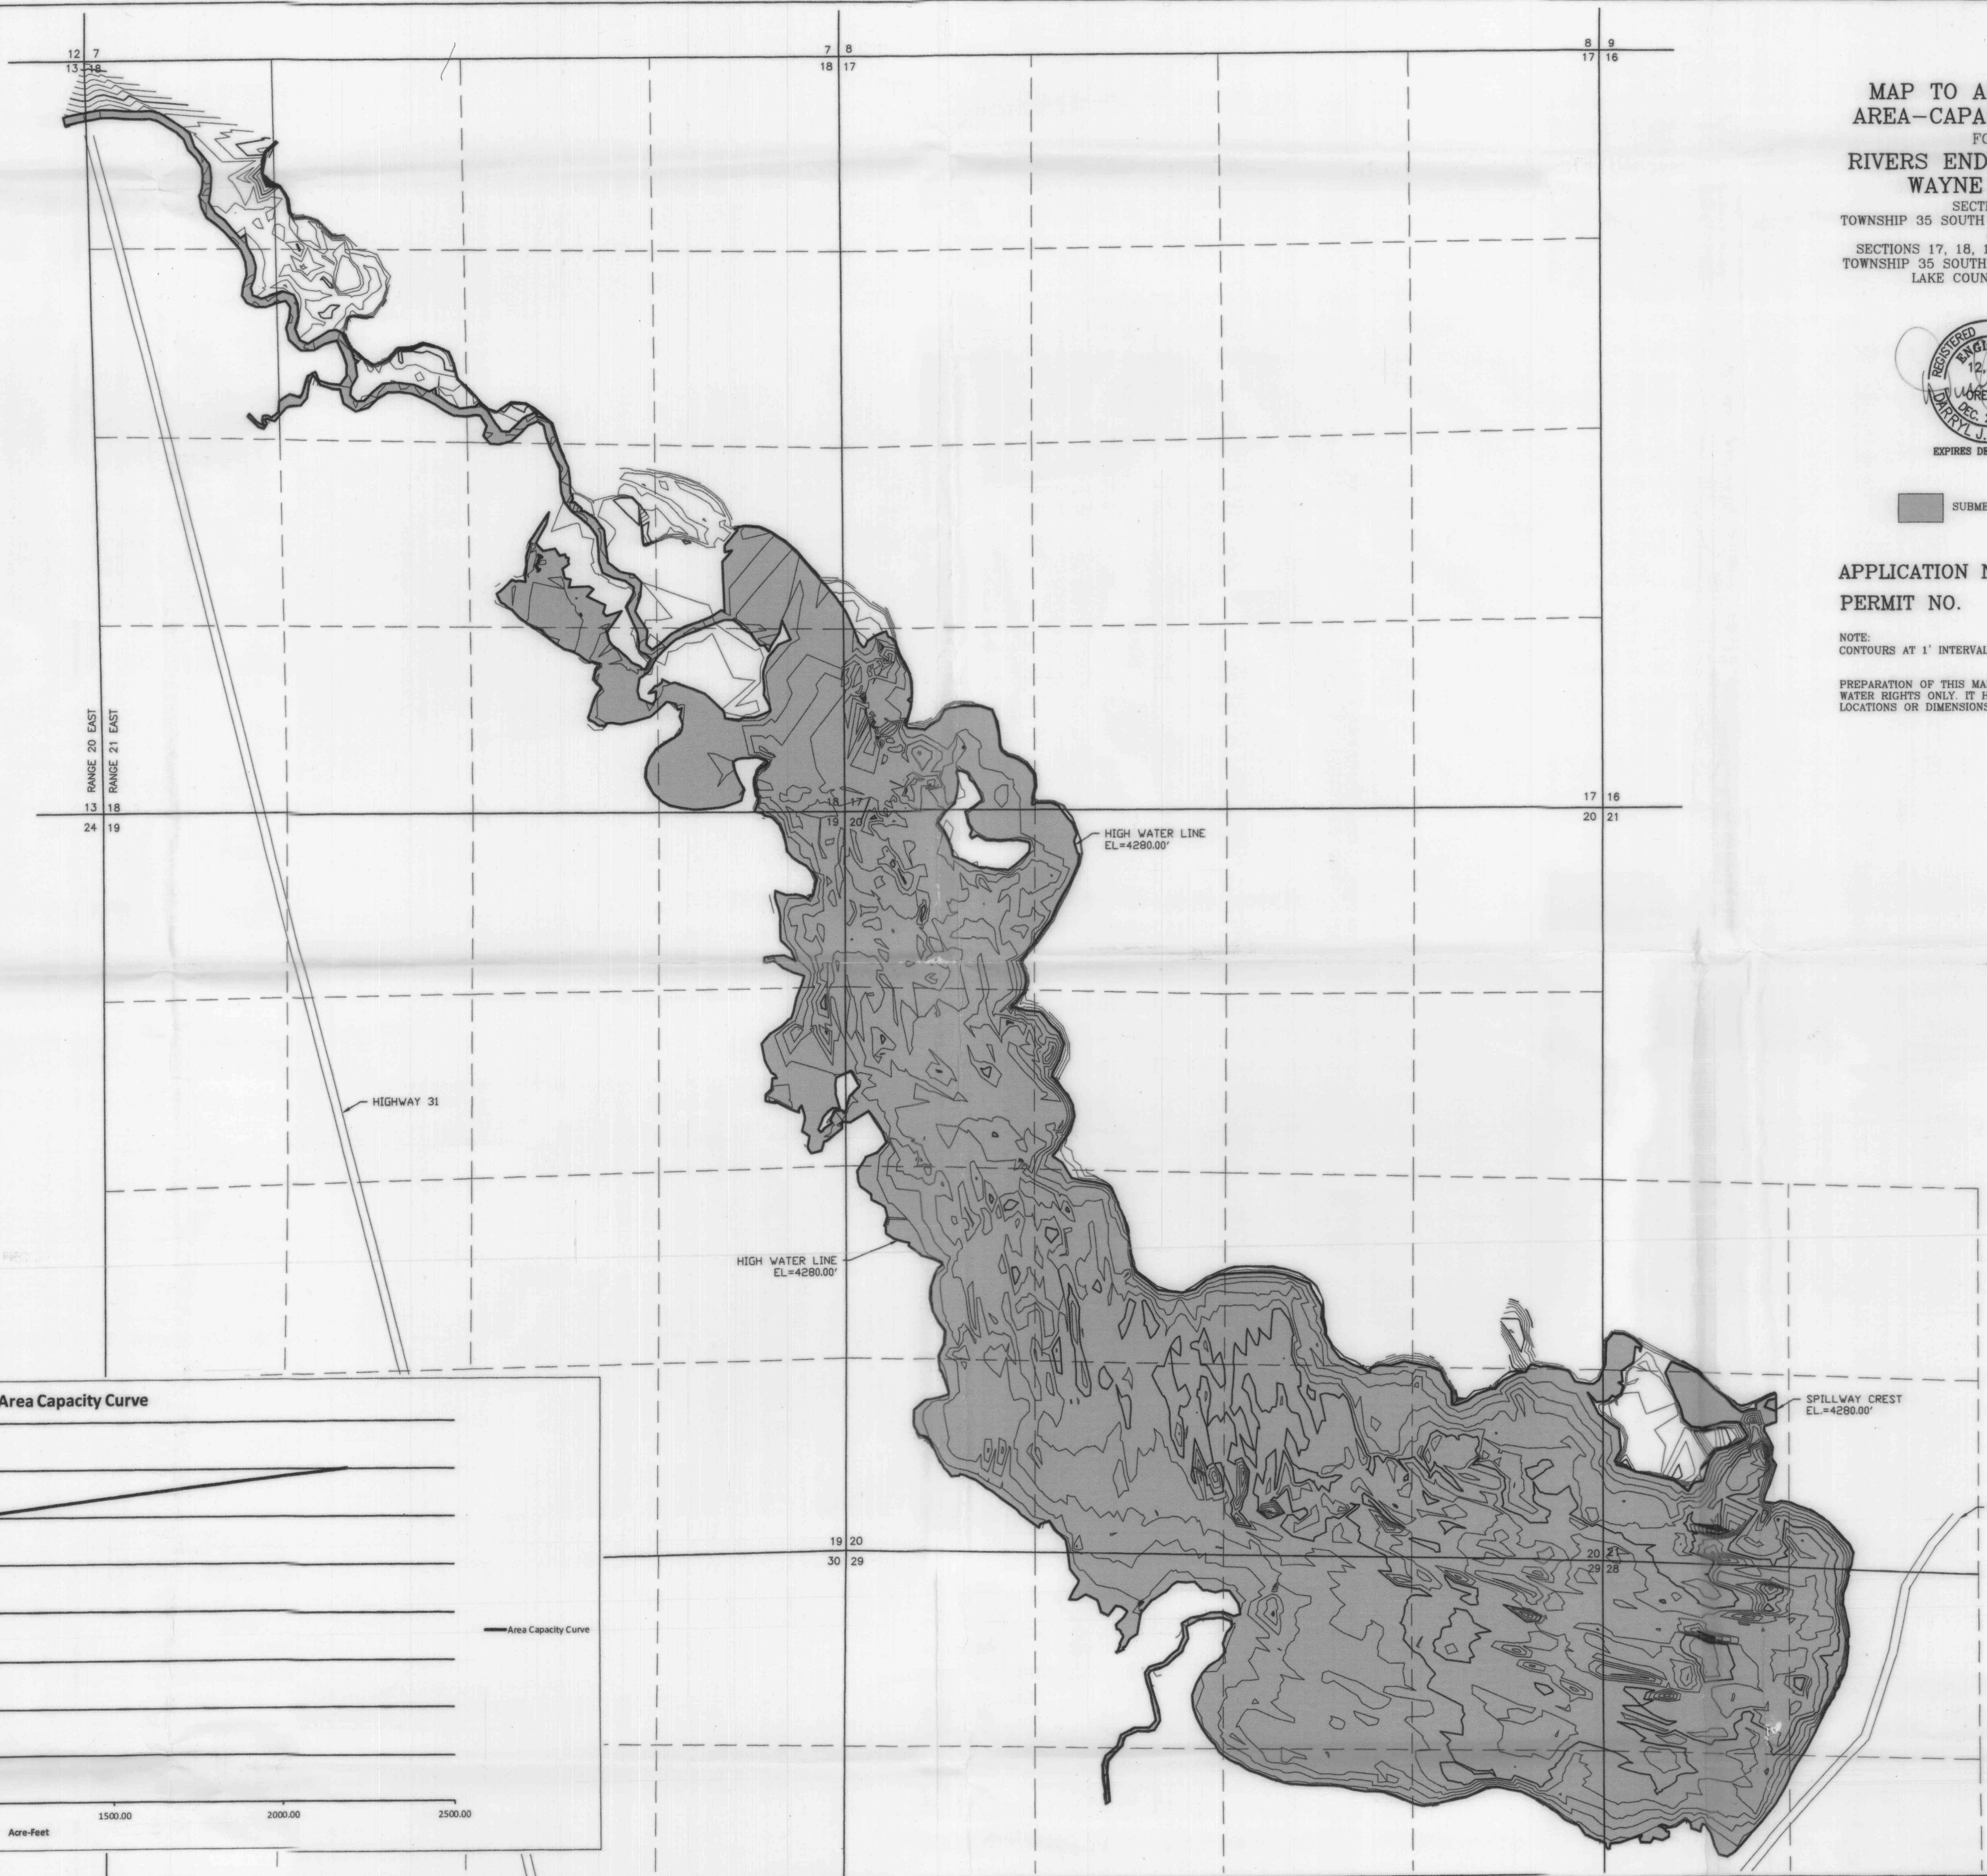

RECEIVED BY OWRD
SEP 11 2015
SALEM, OR

