


T. 38 S., R. 11-1/2 E., W.M.
KLAMATH COUNTY, OREGON

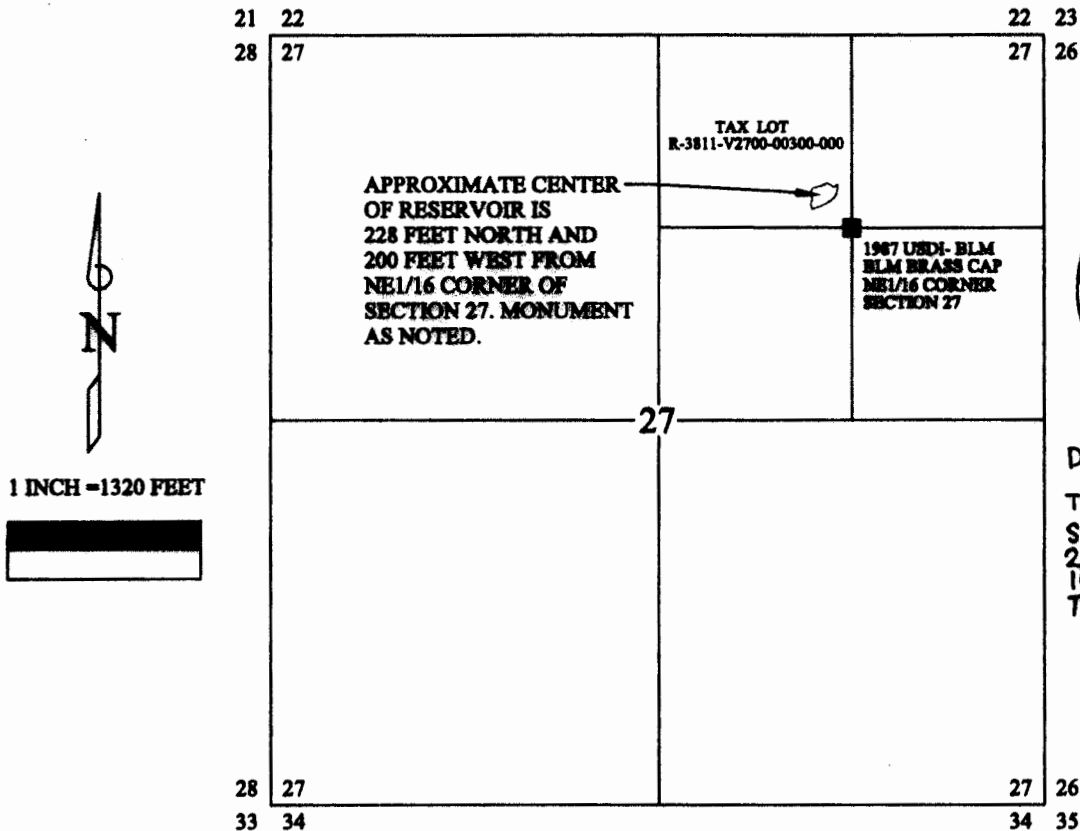

CLAIM OF BENEFICIAL USE MAP

FOR

BELOW DAIRY SIDING RESERVOIR

APPLICATION: R-83422

PERMIT: R-12530

IN THE NAME OF

UNITED STATES BUREAU OF LAND MANAGEMENT

LAKEVIEW DISTRICT


DECEMBER 8, 2014

RECEIVED

JAN 28 2015

OWRD

THE PURPOSE OF THIS MAP IS FOR IDENTIFYING THE LOCATION
OF THE WATER RIGHT ONLY AND IS NOT INTENDED TO PROVIDE
LEGAL DIMENSIONS OR LOCATIONS OF PROPERTY
OWNERSHIP LINES.

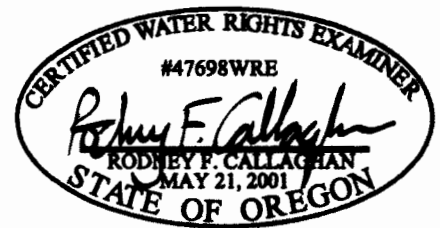

RENEWAL: 12/31/2015

U.S. BUREAU OF LAND MANAGEMENT - OSO

BRANCH OF CADASTRAL SURVEY

DATED: DECEMBER 16, 2014

EXECUTED BY:

RODNEY F. CALLAGHAN, PLS, CWRE
1301 SOUTH G STREET
LAKEVIEW, OR 97630