


TOWNSHIP 17 SOUTH, RANGE 22 EAST, W.M.

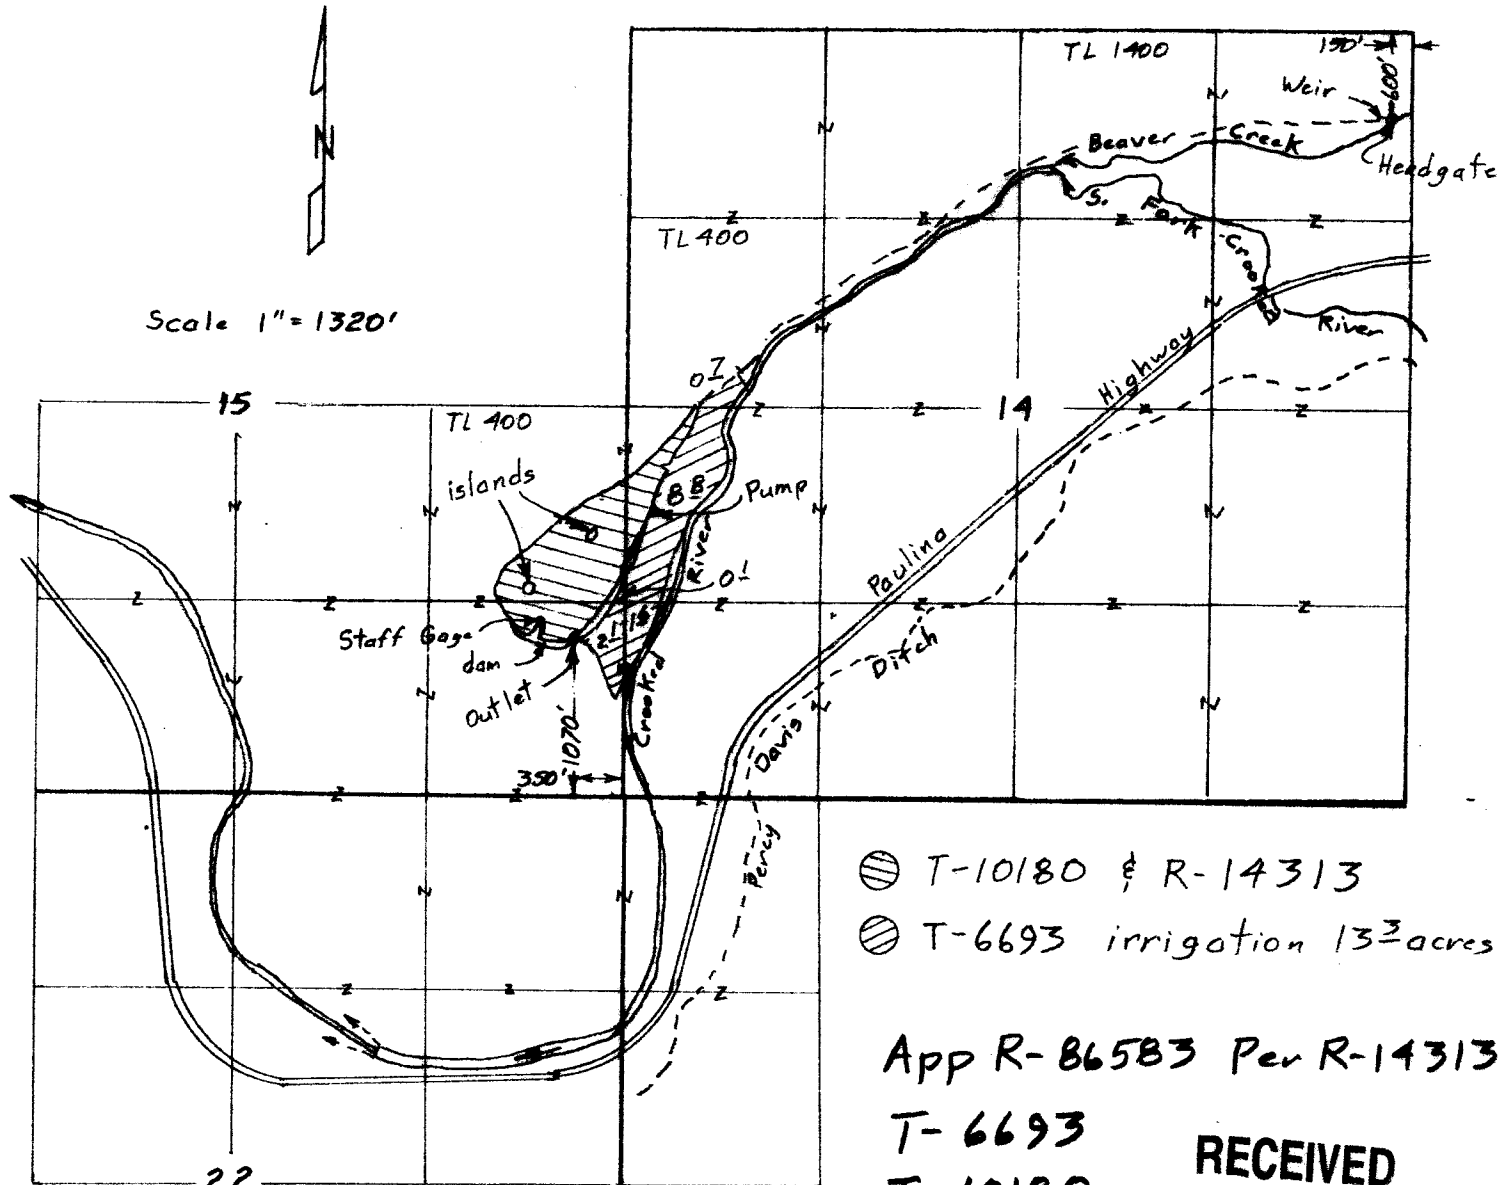

Scale 1" = 1320'

Surveyed July 1, 2009
& March 31, 2011

- ⊗ T-10180 & R-14313
- ⊗ T-6693 irrigation 13³ acres

App R-86583 Per R-14313

T-6693

T-10180

RECEIVED


AUG 30 2011

WATER RESOURCES DEPT
SALEM, OREGON

Claim of Beneficial Use Map **RECEIVED**
for
OREGON RANCHING CO.
(Twin Buttes Ranch)

JUL 20 2011

WATER RESOURCES DEPT
SALEM, OREGON

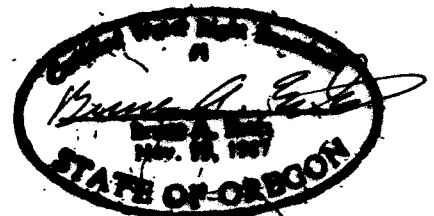

Renewal Dec 31, 2011

This map is for the purpose of
locating a water right only
and has no intent to provide
legal dimensions or the location
of property lines.

