


RECEIVED

Township 10 South, Range 4 West, W.M.

FEB 21 1995

Portions of Sections 5 & 6

WATER RESOURCES DEPT.
SALEM, OREGON

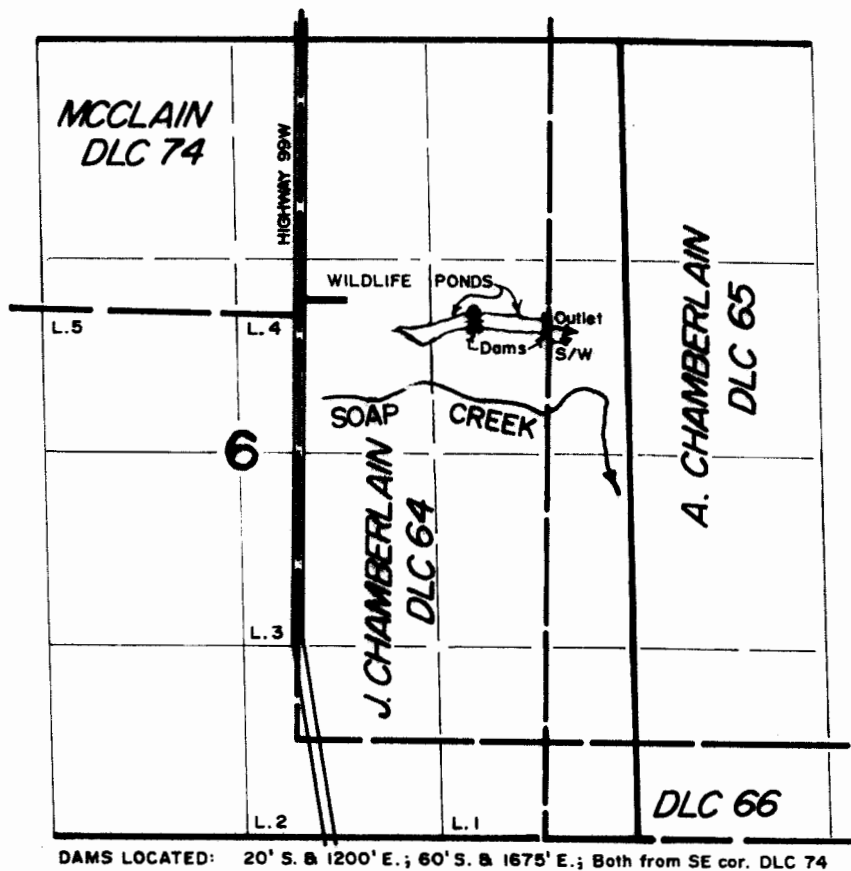

FINAL PROOF SURVEY


under

Appl. No. R-71524, Per. No. R-11407

in name of

GEORGE W. GORDON

February 3, 1995

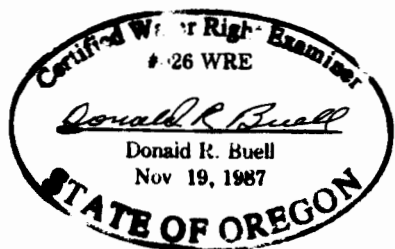

THIS MAP WAS PREPARED FOR THE PURPOSE OF IDENTIFYING THE LOCATION OF A WATER RIGHT ONLY AND IS NOT INTENDED TO PROVIDE LEGAL DIMENSIONS OR LOCATION OF PROPERTY OWNERSHIP LINES.