


Claim of Beneficial Use

Application G-16286

Permit G-15981

In the name of Katherine Morris

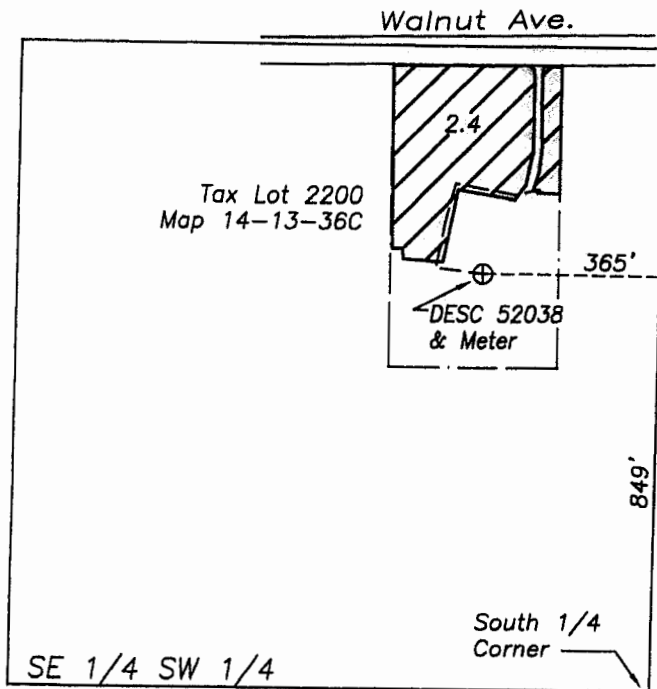


Sec. 36
T14S, R13E, W.M.
Deschutes Co., Oregon

Legend



Water beneficially applied under Permit
G-15981, priority date 8/5/2004.

 

Property line





Mainline


RECEIVED

NOV 23 2009

WATER RESOURCES DEPT
SALEM, OREGON

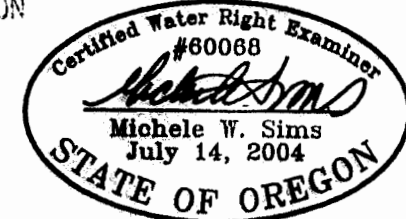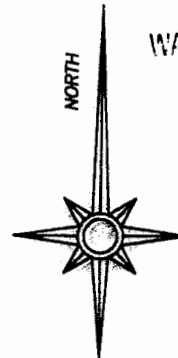

Renewal date: 6/30/2010

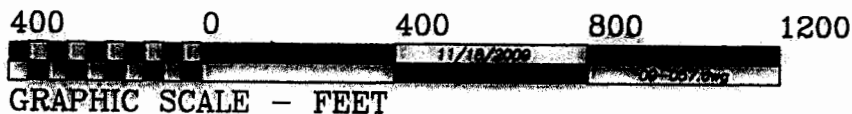

THIS MAP IS FOR THE PURPOSE OF IDENTIFYING THE LOCATION OF THE
WATER RIGHT. IT IS NOT INTENDED TO PROVIDE LEGAL DIMENSIONS OR
LOCATIONS OF PROPERTY OWNERSHIP LINES.