


- HORSE PASTURE
CLOCK IN PUMP HOUSE**
1. ZONE 22 5 15/32"
 2. ZONE 1 3 15/32" 1 RB PU
 3. ZONE 2 4 15/32"
 4. ZONE 3 3 15/32" 1 RB PU
 5. ZONE 4 4 15/32"
 6. ZONE 19 1 15/32" 15 RB PU
 7. ZONE 6 3 15/32"
 8. ZONE 7 2 15/32" 1 RB PU
 9. ZONE 8 2 15/32" 1 RB PU
 10. ZONE 9 3 15/32"
 11. ZONE 11 4 15/32"
 12. ZONE 10 4 15/32"
 13. ZONE 13 7 15/32"
 14. ZONE 14 6 15/32" 1 RB PU
 15. ZONE 18 10 RB PU
 16. ZONE 15 15 RB PU
 17. ZONE 17 8 RB PU
 18. ZONE 5 4 13/32"
 19. ZONE 20 11 RB PU
 20. ZONE 16 15 RB PU
 21. ZONE 21 10 RB PU
 22. ZONE 24 9 RB PU
 23. ZONE 23 15 RB PU
 24. ZONE 12 10 1/4"
 25. ZONE 27 300± DRIP & SPRAY
 26. ZONE 28 300± DRIP & SPRAY

- LAWN AND LANDSCAPE
CLOCK NORTH SIDE NORTH RESIDENCE**
27. ZONE 9-A 12 I-25
 28. ZONE 5-A 6 I-20
 29. ZONE 1-A 7 I-25
 30. ZONE 6-A 7 I-25
 31. ZONE 2-A 4 I-25
 32. ZONE 8-A 6 I-25
 33. ZONE 3-A 17 I-25
 34. ZONE 4-A 5 I-25
 35. ZONE 1-B 12 SPRAYER
 36. ZONE 2-B 6 I-20
 37. ZONE 8-B 22 SPRAYER
 38. ZONE 6-B 11 SPRAYER
 39. ZONE 7-B 10 SPRAYER & 5 I-20
 40. ZONE 11-B 14 SPRAYER
 41. ZONE 4-B 7 SPRAYER
 42. ZONE 5-B 11 SPRAYER
 43. ZONE 10-B 22 SPRAYER
 44. ZONE 3-B 11 SPRAYER
 45. ZONE 12-B DRIP
 46. ZONE 9-B 14-SPRAYER

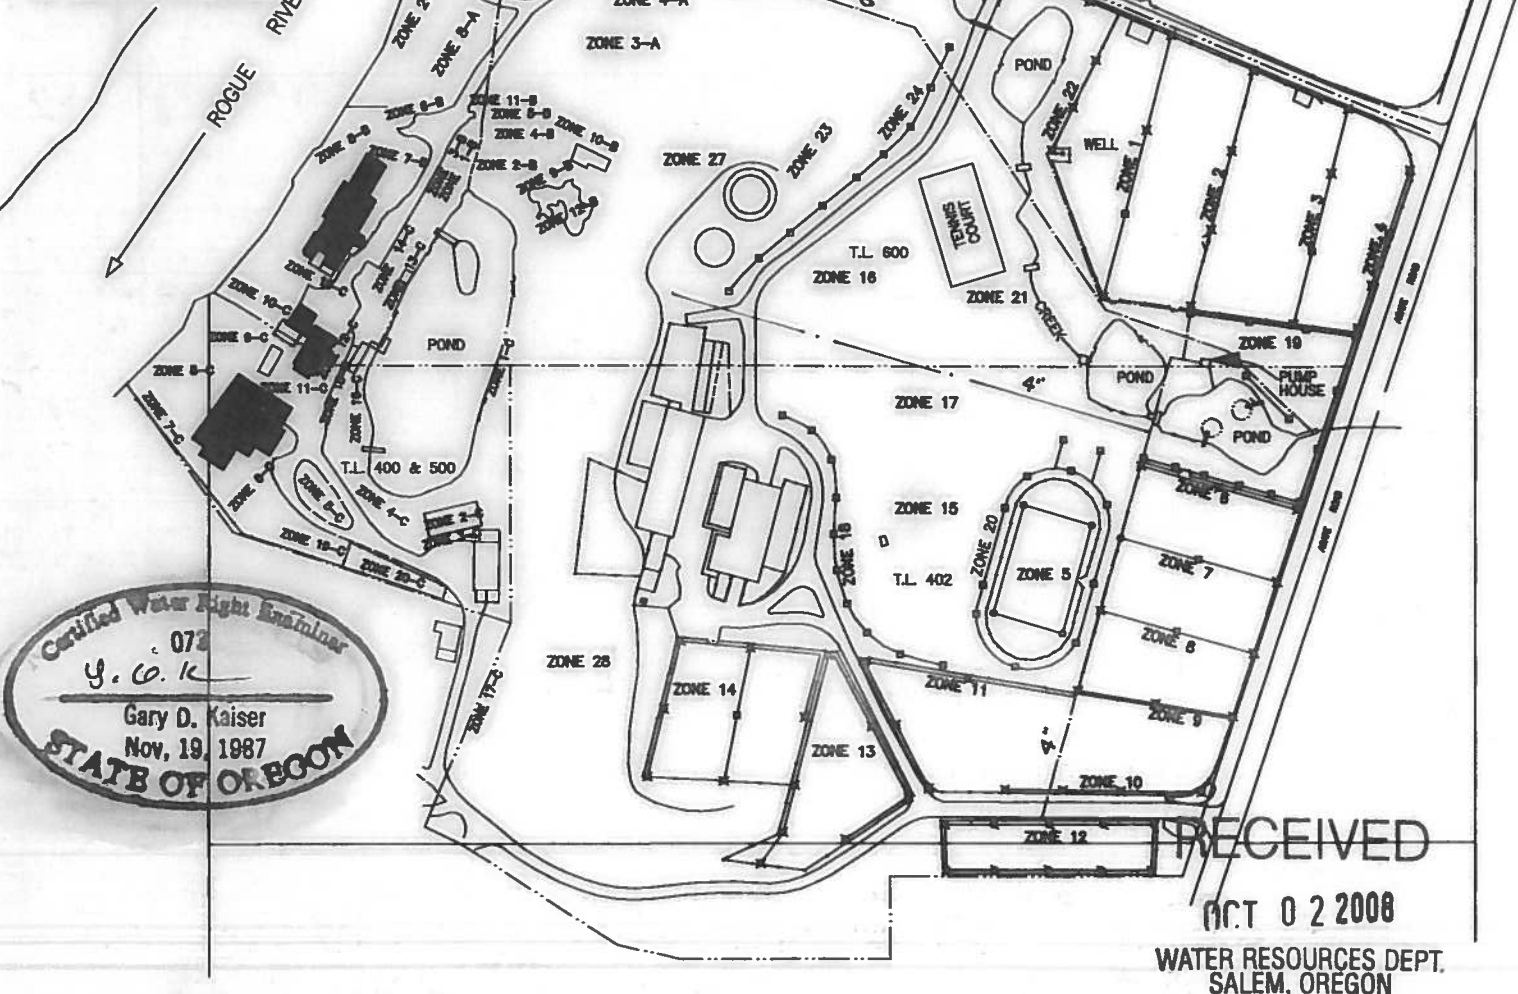

Certified Water Right Examiner
073
y.c.k.
Gary D. Kaiser
Nov. 19, 1987
STATE OF OREGON

RECEIVED
OCT 02 2008
WATER RESOURCES DEPT.
SALEM, OREGON


T.35S.,R.1W.,W.M.
Tax Lot Nos. 400, 500, 600 & 402
Jackson County, Oregon

**EXHIBIT 1
IRRIGATION ZONES
(66 ZONES)**



SCALE 1" = 200'

T.35S.,R.1W.,W.M.
Tax Lot Nos. 400, 500, 600 & 402
Jackson County, Oregon

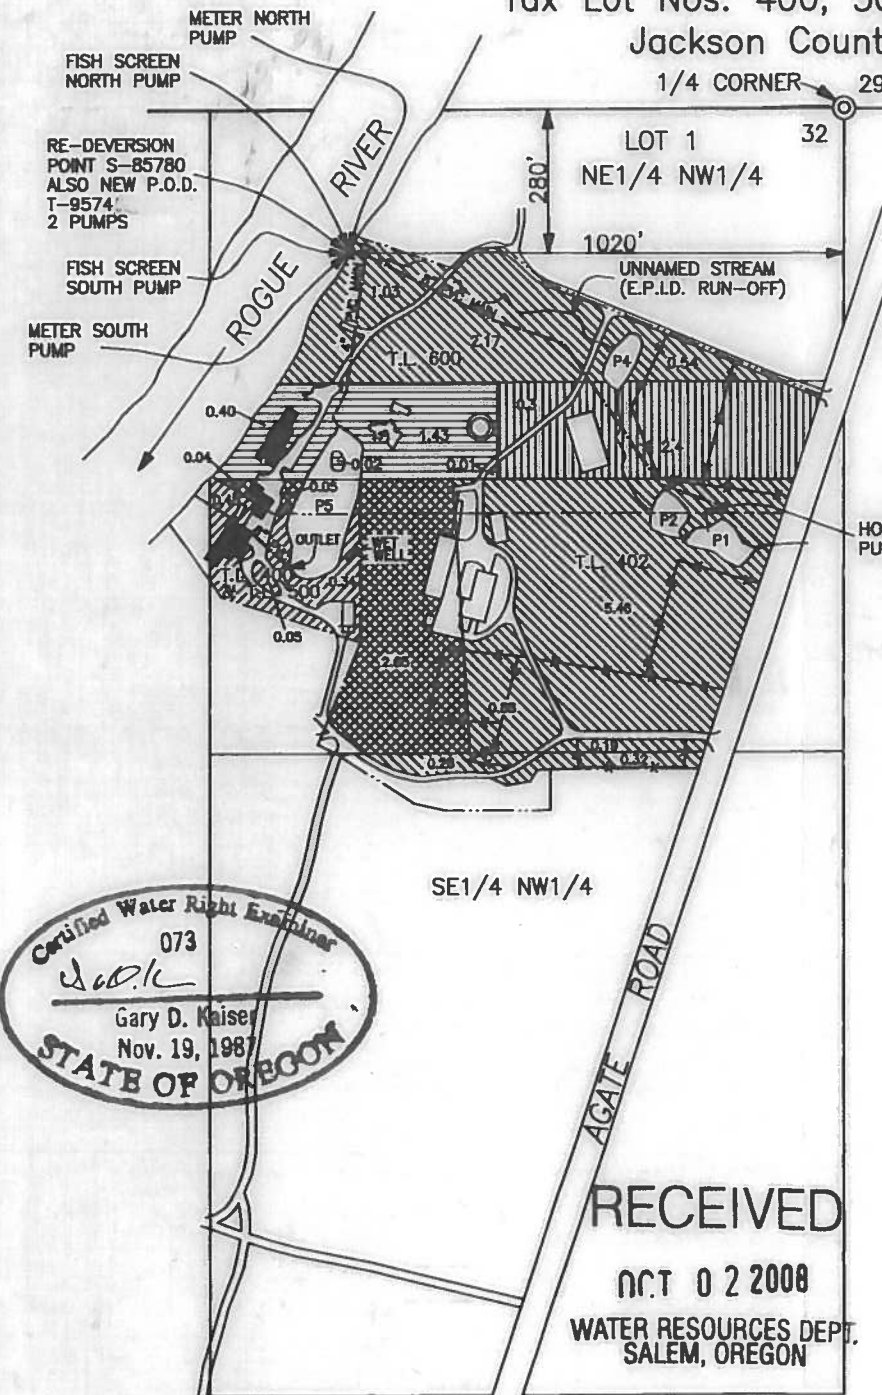

Certified Water Right Examiner
073
y.c.k.
Gary D. Kaiser
Nov. 19, 1987
STATE OF OREGON

CLAIM OF BENEFICIAL USE MAP
APPLICATION No. S-85870, PERMIT No. 54055 AND T-9574 WATER APPLIED THROUGH SAME SYSTEM - NO WAY TO SEPERATE ON MAP

FOR: LINDA ISOLA
JAMES BAYER and TONI ISOLA-BAYER
JOHNNIE ISOLA and NICOLE ISOLA
12271 Agate Road
Eagle Point, OR. 97524

PREPARED BY:
Gary D. Kaiser
19440 Highway 62
Eagle Point, OR. 97524

September 19, 2008

NOTE: MAP PREPARED FOR WATER RIGHT PURPOSES ONLY, NOT FOR PROPERTY BOUNDARY LOCATIONS.

LOST CREEK RESERVOIR
POINT OF DIVERSION
T.33S.,R.1E.,W.M.
SCALE 1" = 2640'