

TAX LOTS:
9 5W 18 201
9 5W 18 400

POD 2: 910' N & 1700' E OF SW COR DLC 55
FISH SCREEN ON POD INTAKE IN RIVER
FLOW METER 50' NW OF POD 2

FINAL PROOF SURVEY

UNDER


Application No. S-86964 Permit No. S-54496

IN THE NAME OF

STEVE HAMILTON


JUNE 14, 2009

SCALE: 1" = 1320'

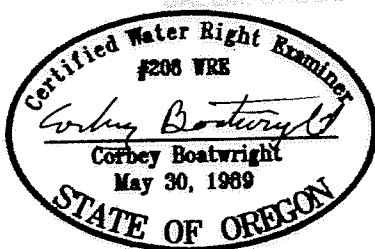

RENEWAL DATE: 12-31-11

NOTE: This map is not intended to provide legal dimensions or locations of property ownership lines.

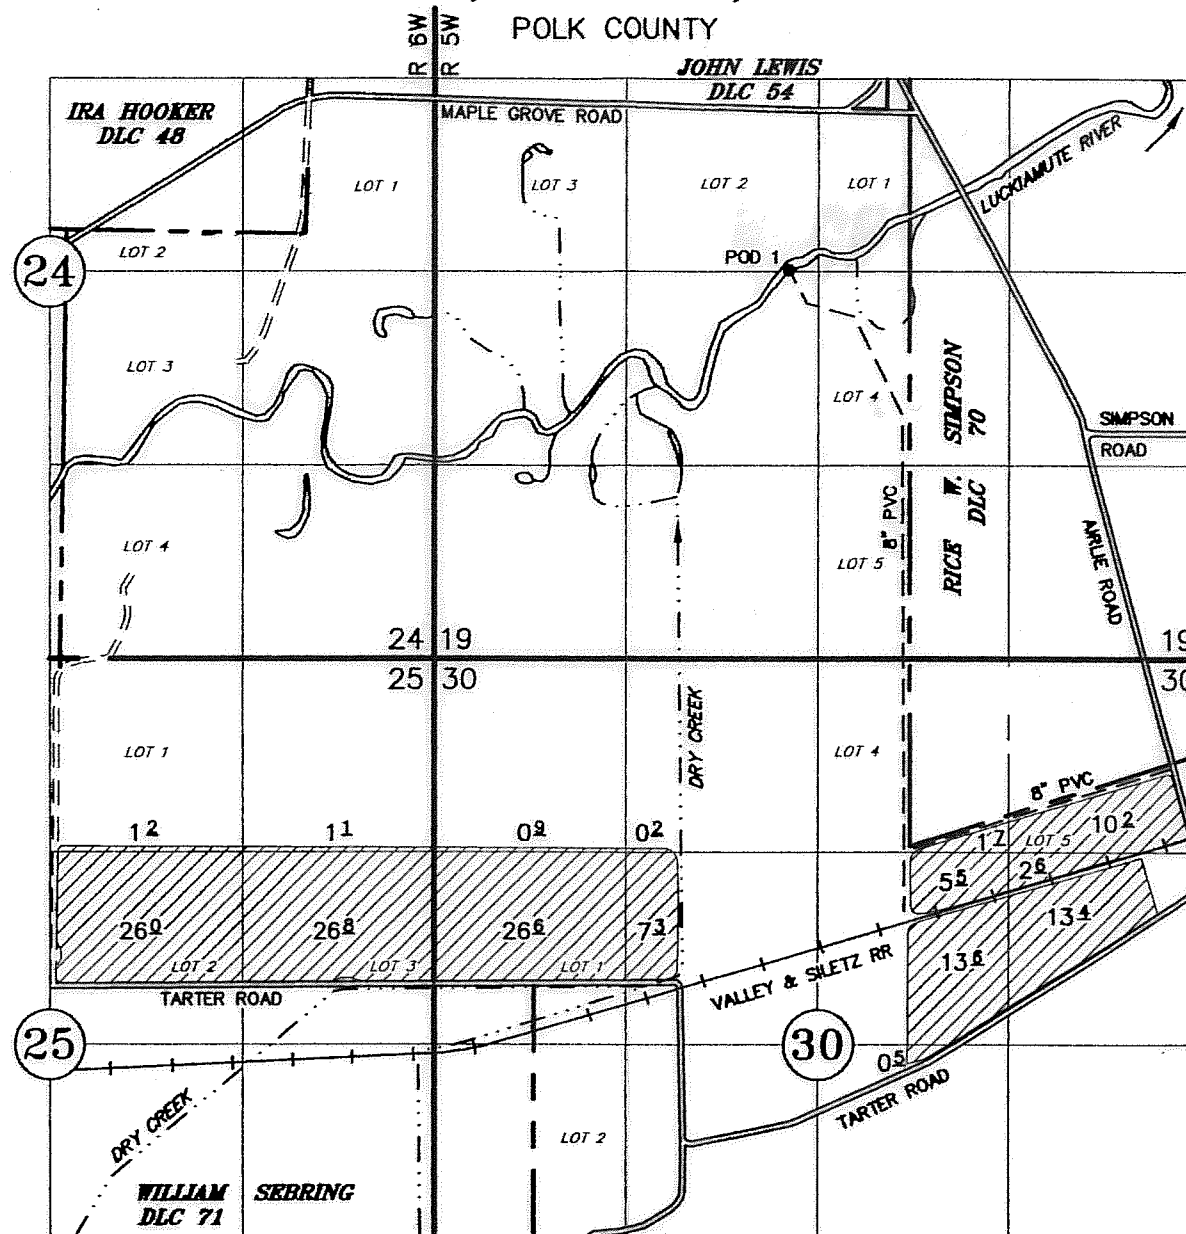

TAX LOTS:
9 6W 25 200
9 5W 19 700
9 5W 30 201
9 5W 30 202
9 5W 30 301
9 5W 30 503
9 5W 30 800

POD 1: 3930' N & 840' W OF SW COR DLC 70
FISH SCREEN ON POD INTAKE IN RIVER
FLOW METER 60' SE OF POD 1 ON LINE ABOVE GROUND

FINAL PROOF SURVEY

UNDER


Application No. S-86964 Permit No. S-54496

IN THE NAME OF

STEVE HAMILTON

JUNE 14, 2009

SCALE: 1" = 1320'

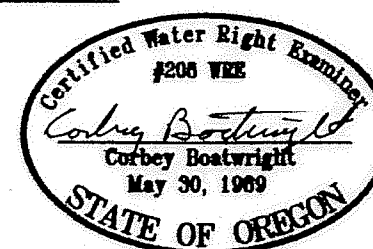

RENEWAL DATE: 12-31-11

NOTE: This map is not intended to provide legal dimensions or locations of property ownership lines.

RECEIVED
JAN 13 2010
WATER RESOURCES DEPT
SALEM, OREGON