

SE 1/4 OF SW 1/4 & SW 1/4 OF SE 1/4 SEC. 10 &
 NE 1/4 OF NW 1/4 SEC. 15, T. 7 S., R. 4 W., W.M.
 POLK COUNTY, OREGON
 OCTOBER 27, 2010

**CLAIM OF BENEFICIAL USE MAP
 RESERVOIR & IRRIGATION**

UNDER

APPLICATION NO. S-83950 R-83949 PERMIT NO. 53583 R-12658

DIVERSION POINT:
 FOR RESERVOIR BEING
 324' NORTH AND 440' WEST OF 1/4 CORNER.
 COMMON TO SECTIONS 10 & 15.



9 10
 14 15
 SEC. CORNER
 B.C./CONC.
 RE: D-117

NOTE:
 THIS MAP IS FOR THE
 PURPOSE OF IDENTIFYING
 WATER RIGHTS AND HAS
 NO INTENT TO DIMENSION
 OR LOCATE PROPERTY
 OWNERSHIP LINES.

IN THE NAME OF:
FLYNN CASE
 2800 OAK GROVE RD.
 RICKREALL, OR 97371

LEGEND
 ● = MONUMENT FOUND AS NOTED.
 I.P./I.R. = IRON PIPE/IRON ROD
 A.C. - B.C. = ALUMINUM CAP - BRASS CAP
 AC. = ACRES

MAP PREPARED BY:
J & R SURVEYORS
 P.O. BOX 418
 DALLAS, OR. 97338
 Ph.# (503) 623-4003

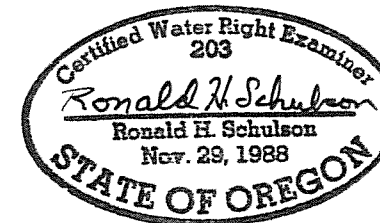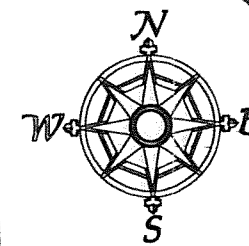

RECEIVED

NOV 01 2010

WATER RESOURCES DEPT
 SALEM, OREGON

400' 800'

CAD BY: Jeff

COBU MAP #549

J&R NO. 10-03-02

6450

