


T6S, R5W, WM

POLK COUNTY

DEC 21 2010

TAX LOT:
POLK COUNTY
6.5.12 200

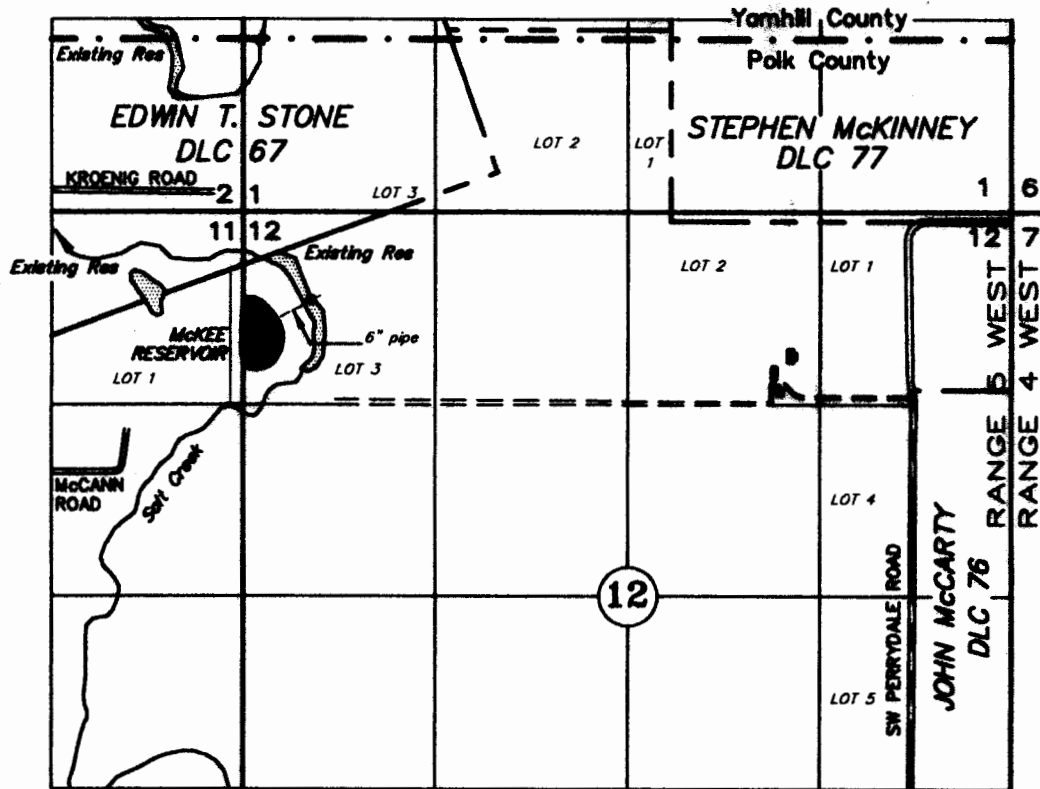

DIV PT: 880' S AND 1285' W OF THE SE CORNER EDWIN T STONE DLC NO 67
FISH SCREEN: WEST OF DIV PT ON PUMP INTAKE
TRICKLE TUBE: 995' S AND 1495' W OF THE SE CORNER EDWIN T STONE DLC NO 67
FLOW METER: 850' S AND 1215' W OF THE SE CORNER EDWIN T STONE DLC NO 67

FINAL PROOF SURVEY

UNDER


Application No. S-86067
R-86066 Permit No. S-54144
R-14088

IN THE NAME OF

BOB McKEE

SEPTEMBER 15, 2010

SCALE: 1" = 1320'

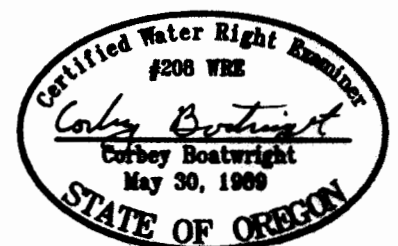

NOTE: This map is not intended to provide legal dimensions or locations of property ownership lines.

EXPIRES 12-31-11