


FINAL PROOF MAP
 SW1/4NE1/4 and NW1/4SE1/4 Section 13,
 T. 39 S., R. 3 W., W.M., Jackson County, Oregon
 For
 Bo P. Boyajian
 2639 Little Applegate Road
 Jacksonville, OR. 97530

T. 39 S., R. 3 W., Sec. 13

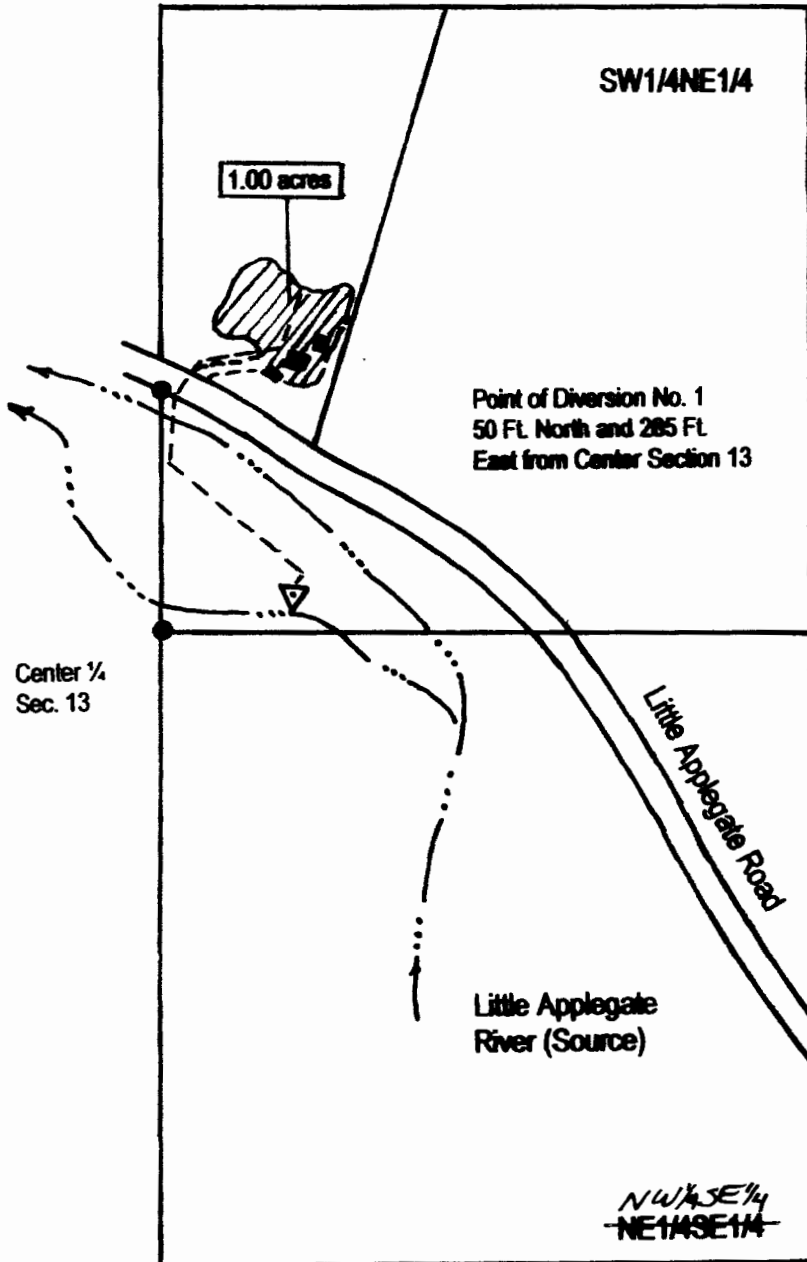

LEGEND



Date: July 21, 2005
 Scale: 1" = 400'

- Found Survey Monument
- Denotes Building

Denotes area under Special Order
 Volume 56, Pages 2178-2180, Priority
 Date October 23, 1980.


Certified Water Right Examiner
 HAROLD L. CENTER, P.L.S., C.W.R.E.
 2604 David Lane - Medford, OR. 97504
 541-535-6108, Fax 541-535-8752
 Oregon C.W.R.E. No. 152
 Certificate Renewal Date, 12/31/05

This map was prepared for the purpose of identifying the location of a water right only and is not intended to provide legal dimensions or location of property ownership.

RECEIVED

SEP 21 2005

WATER RESOURCES DEP.
 SALEM OREGON

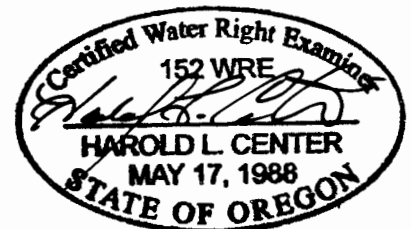

Map updated by WRD to reflect correct 1/4 of the NWSE. mfb/wrd 3-18-16