
CASTRO PIPELINE AS BUILT

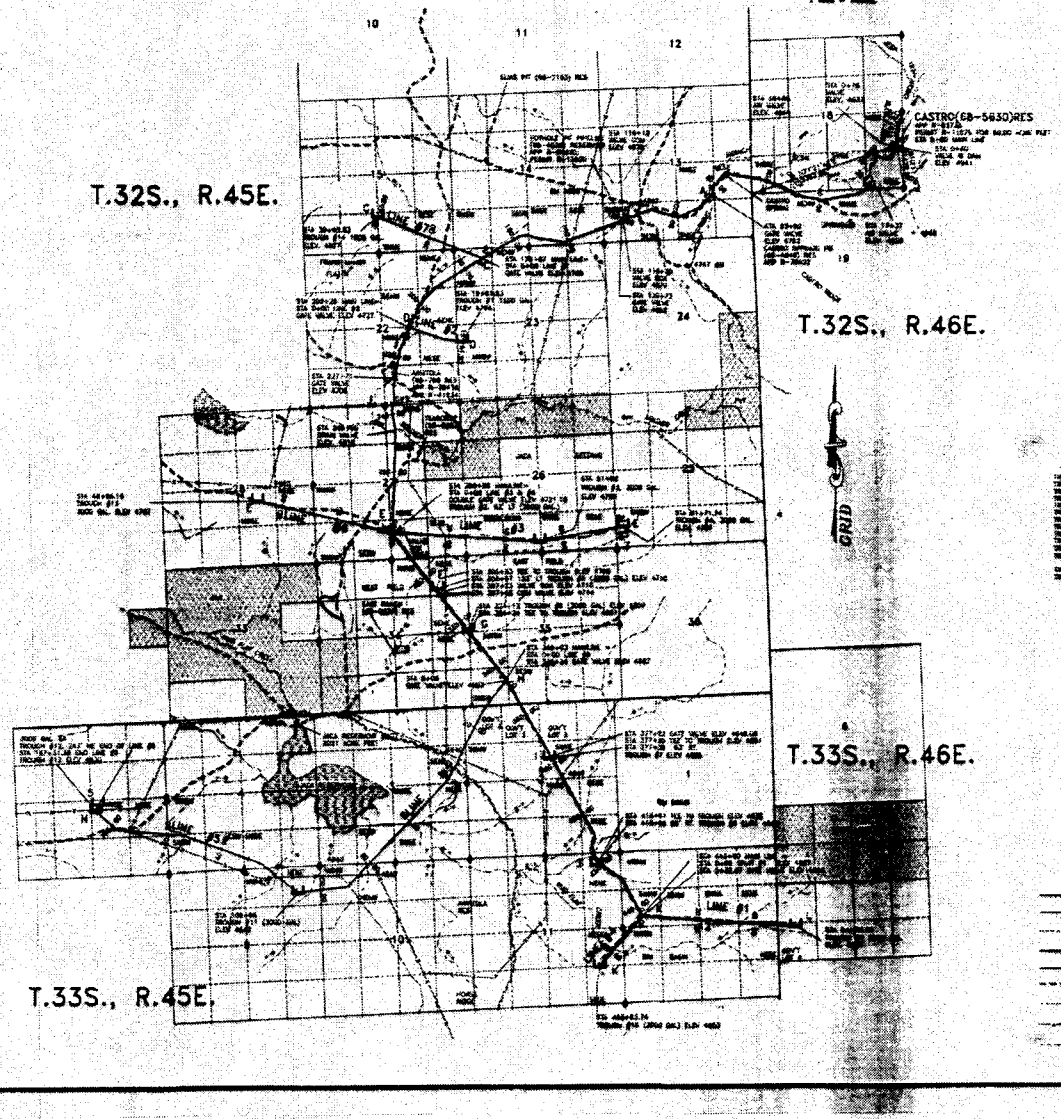

DESCRIPTION

LINE STATIONING

TROUGH LOCATIONS

SECTION CORNERS

LEGEND

- TOWNSHIP LINE
- SECTION LINE
- 40 LINE
- MAIN PIPELINE
- SPUR PIPELINE
- ROAD
- TRAIL
- FENCE
- CHANNEL
- FOUND SECTION CORNER
- TROUGH
- PRIVATE PROPERTY
- BENCHMARK (U.S.G.S. QUAD)
- RESERVOIR (NOT ON QUAD)
- RESERVOIR (ON QUAD)

RECEIVED
SEP 27 2000
WATER RESOURCES DEPT.
SALEM, OREGON

REV. NO.	DESCRIPTION	DATE	APPROVED

UNITED STATES DEPARTMENT OF THE INTERIOR
BUREAU OF LAND MANAGEMENT
VALE DISTRICT — OREGON

AS BUILT
CASTRO PIPELINE

DESIGNED	
REVIEWED	
APPROVED	
DRAWN: CG	SCALE: 1"=2000'
DATE: 09/08/00	SHEET 2 OF 4
ACAD14/SGSK8.0 CASTROPPL.DWG	DRAWING NO. DR-03-9172.45-1041

COBU MAP # 0124-2