

FINAL PROOF SURVEY MAP
 LOCATED IN THE NW¼ SW¼ OF SECTION 9,
 TOWNSHIP 23 SOUTH, RANGE 12 WEST, W.M.
 COOS COUNTY, OREGON
 APPLICATION S-86835 PERMIT S-54497

RECEIVED

MAR 06 2009

WATER RESOURCES DEPT
 SALEM, OREGON

PREPARED FOR: Carl O. & Mary J. George
 M. Nicholas & Deanne E. Workhoven
 PREPARED BY: Dennis Goude
 DATE: February 6, 2009

Scale 1"=400'


LEGEND

P.O.B. 
 P.O.D. 
 PIPE 
 PLACE OF USE 
 15' WIDE
 WATER SYSTEM EASEMENT 

NOTE:

THE POINT OF DIVERSION IS LOCATED 1218 FEET NORTH AND 665 FEET EAST OF THE GOVERNMENT MEANDER CORNER WHICH IS 691.68 FEET NORTH OF THE SOUTHWEST CORNER OF SECTION 9, TOWNSHIP 23 SOUTH, RANGE 12 WEST, W.M. PERMIT READS 1910 FEET NORTH AND 665 FEET EAST FROM THE SW CORNER OF SECTION 9.

NOTE:
 TOTALIZING FLOW METERS
 WORKHOVEN SERIAL #33006775,
 GEORGE SERIAL #33106600.

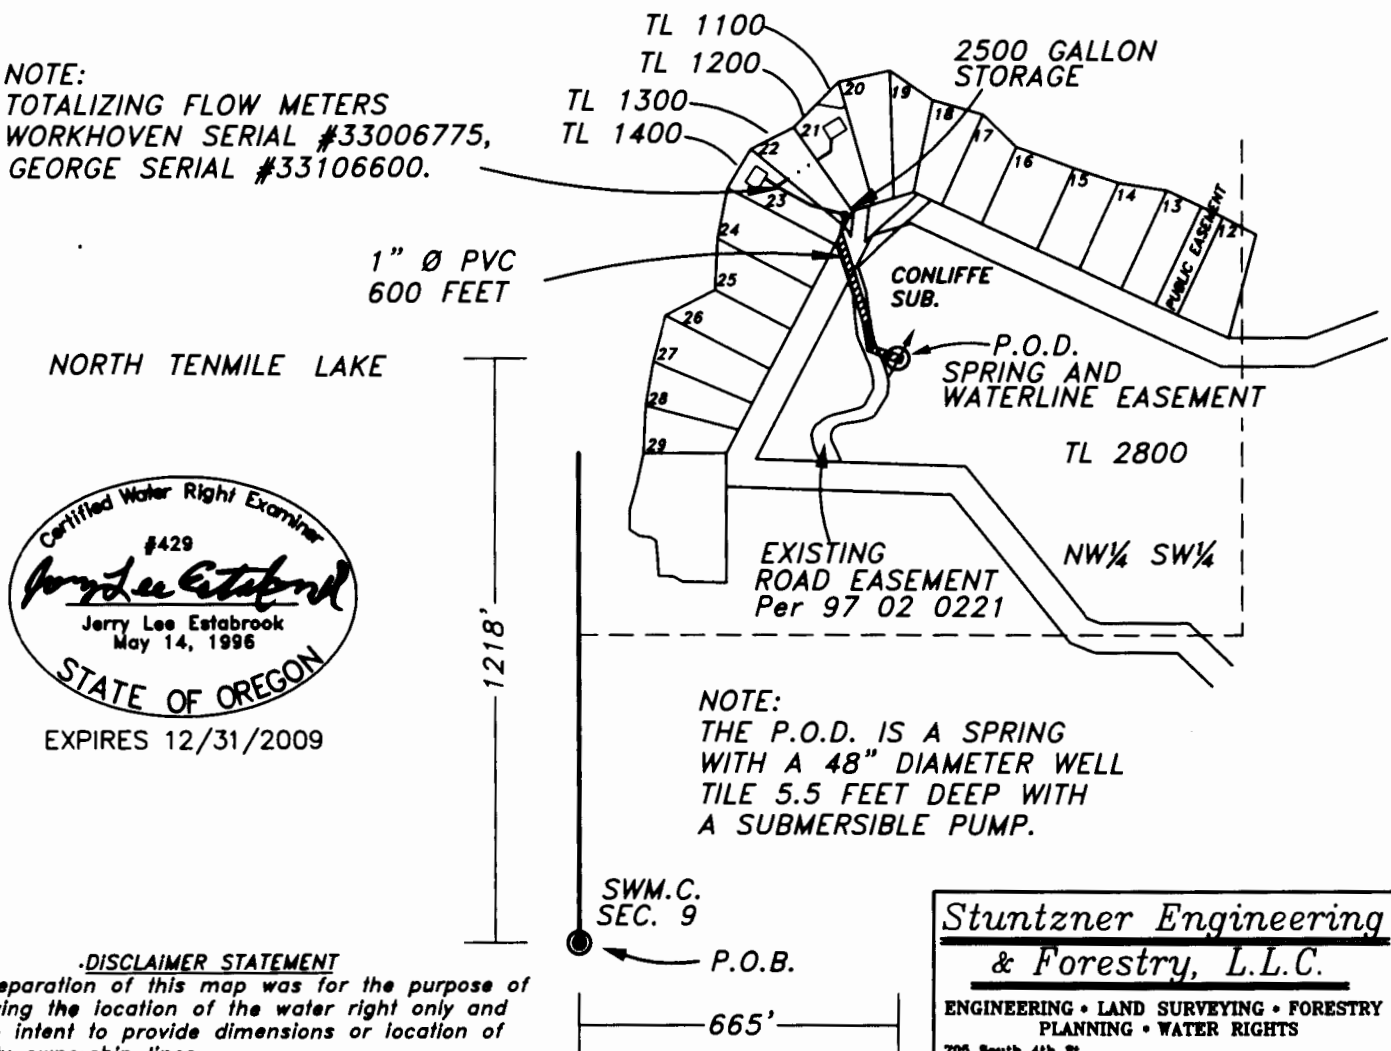

DISCLAIMER STATEMENT

The preparation of this map was for the purpose of identifying the location of the water right only and has no intent to provide dimensions or location of property ownership lines.

Stuntzner Engineering
 & Forestry, L.L.C.
 ENGINEERING • LAND SURVEYING • FORESTRY
 PLANNING • WATER RIGHTS
 705 South 4th St.
 Post Office Box 118
 Coos Bay, Oregon 97420
 Phone: (541) 267-2872
 Fax: (541) 267-0588