


Sec. 10
15
Tp. 14 S.
R. 30 E.

Permit # 8049
9134

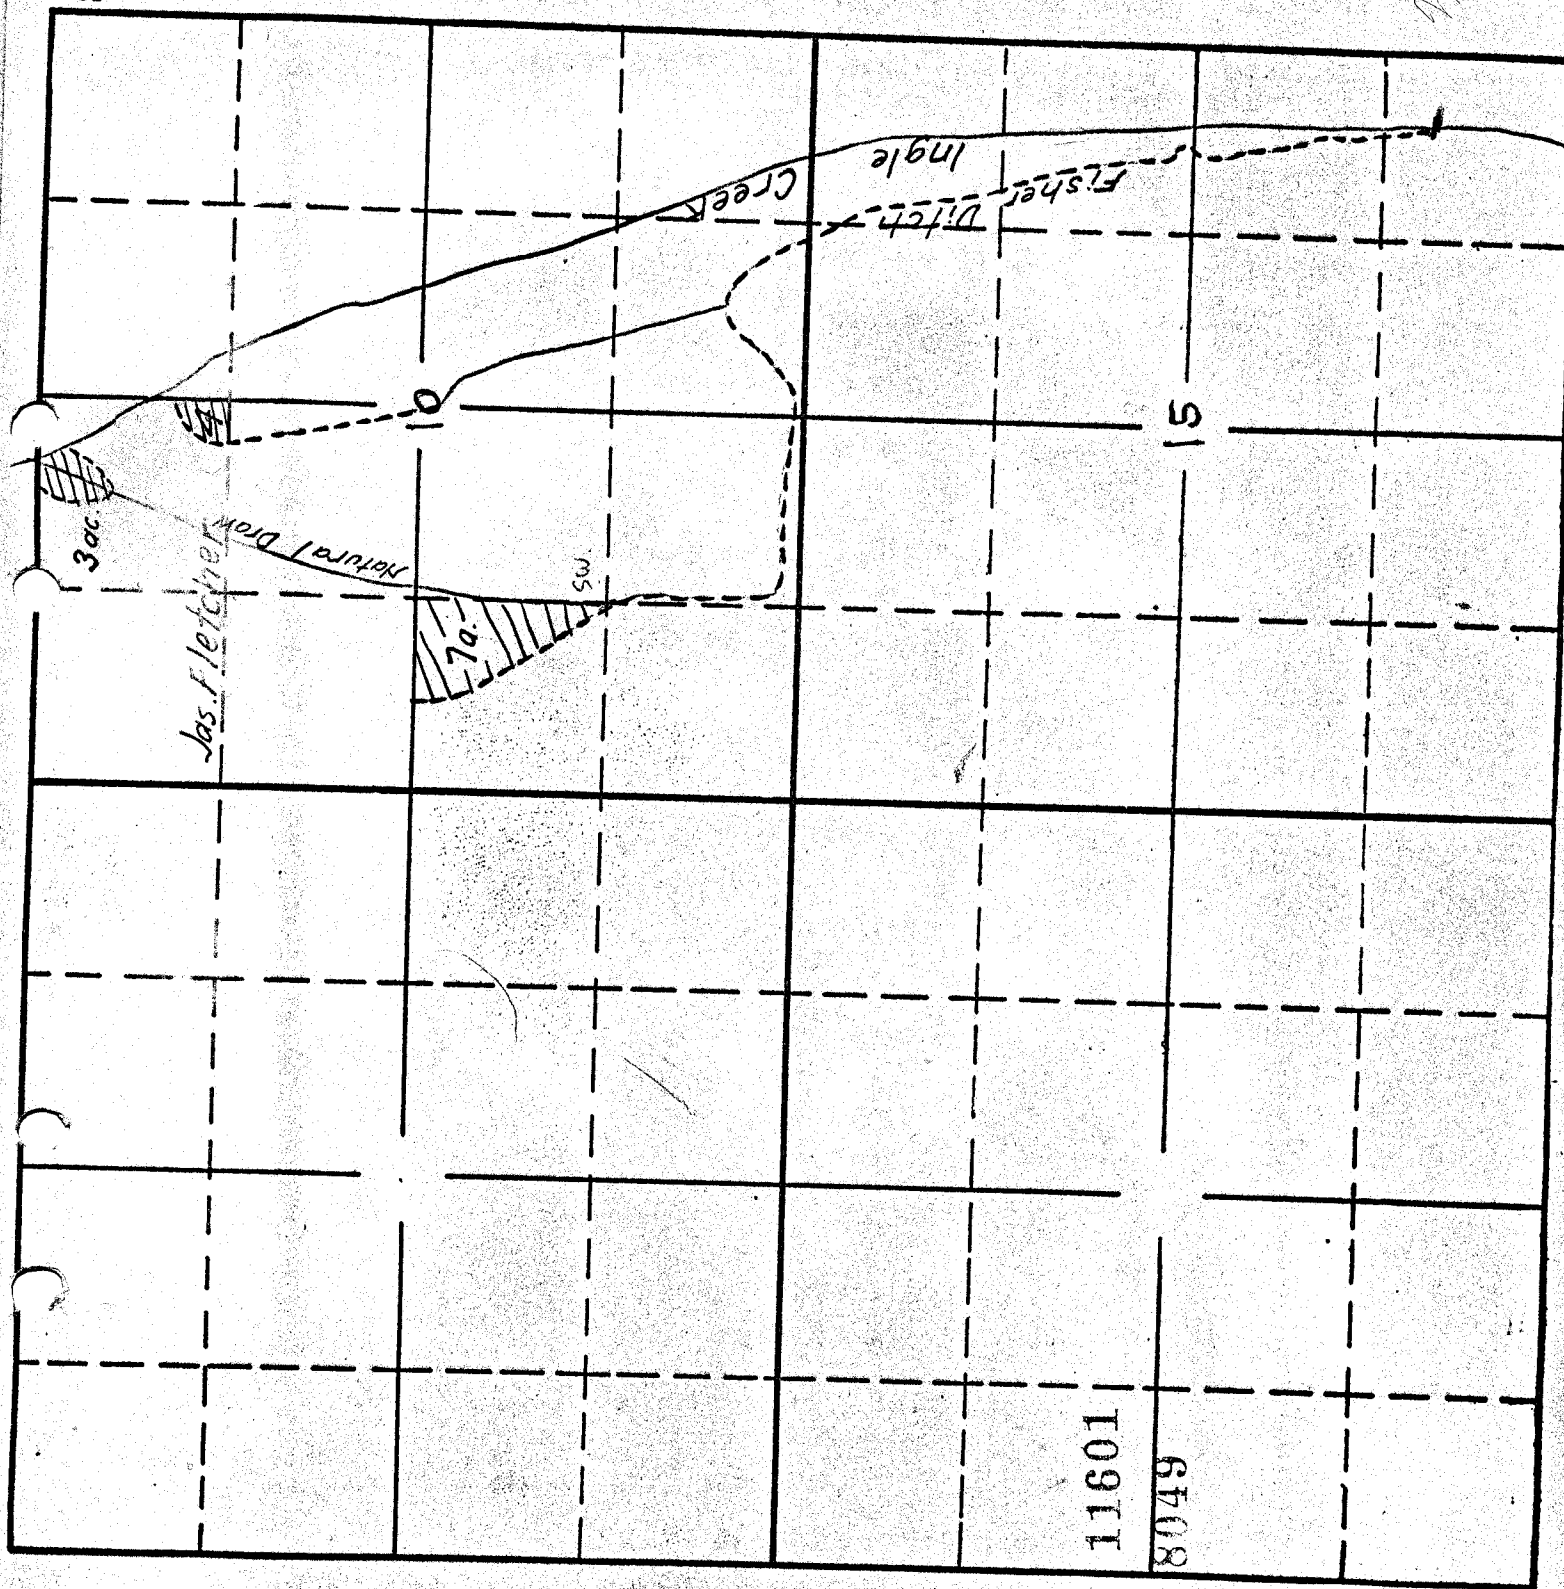

Application No. 11601
Permit No. 8049