



956

RECEIVED

FEB 17 2016

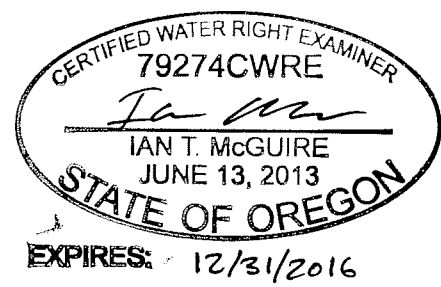

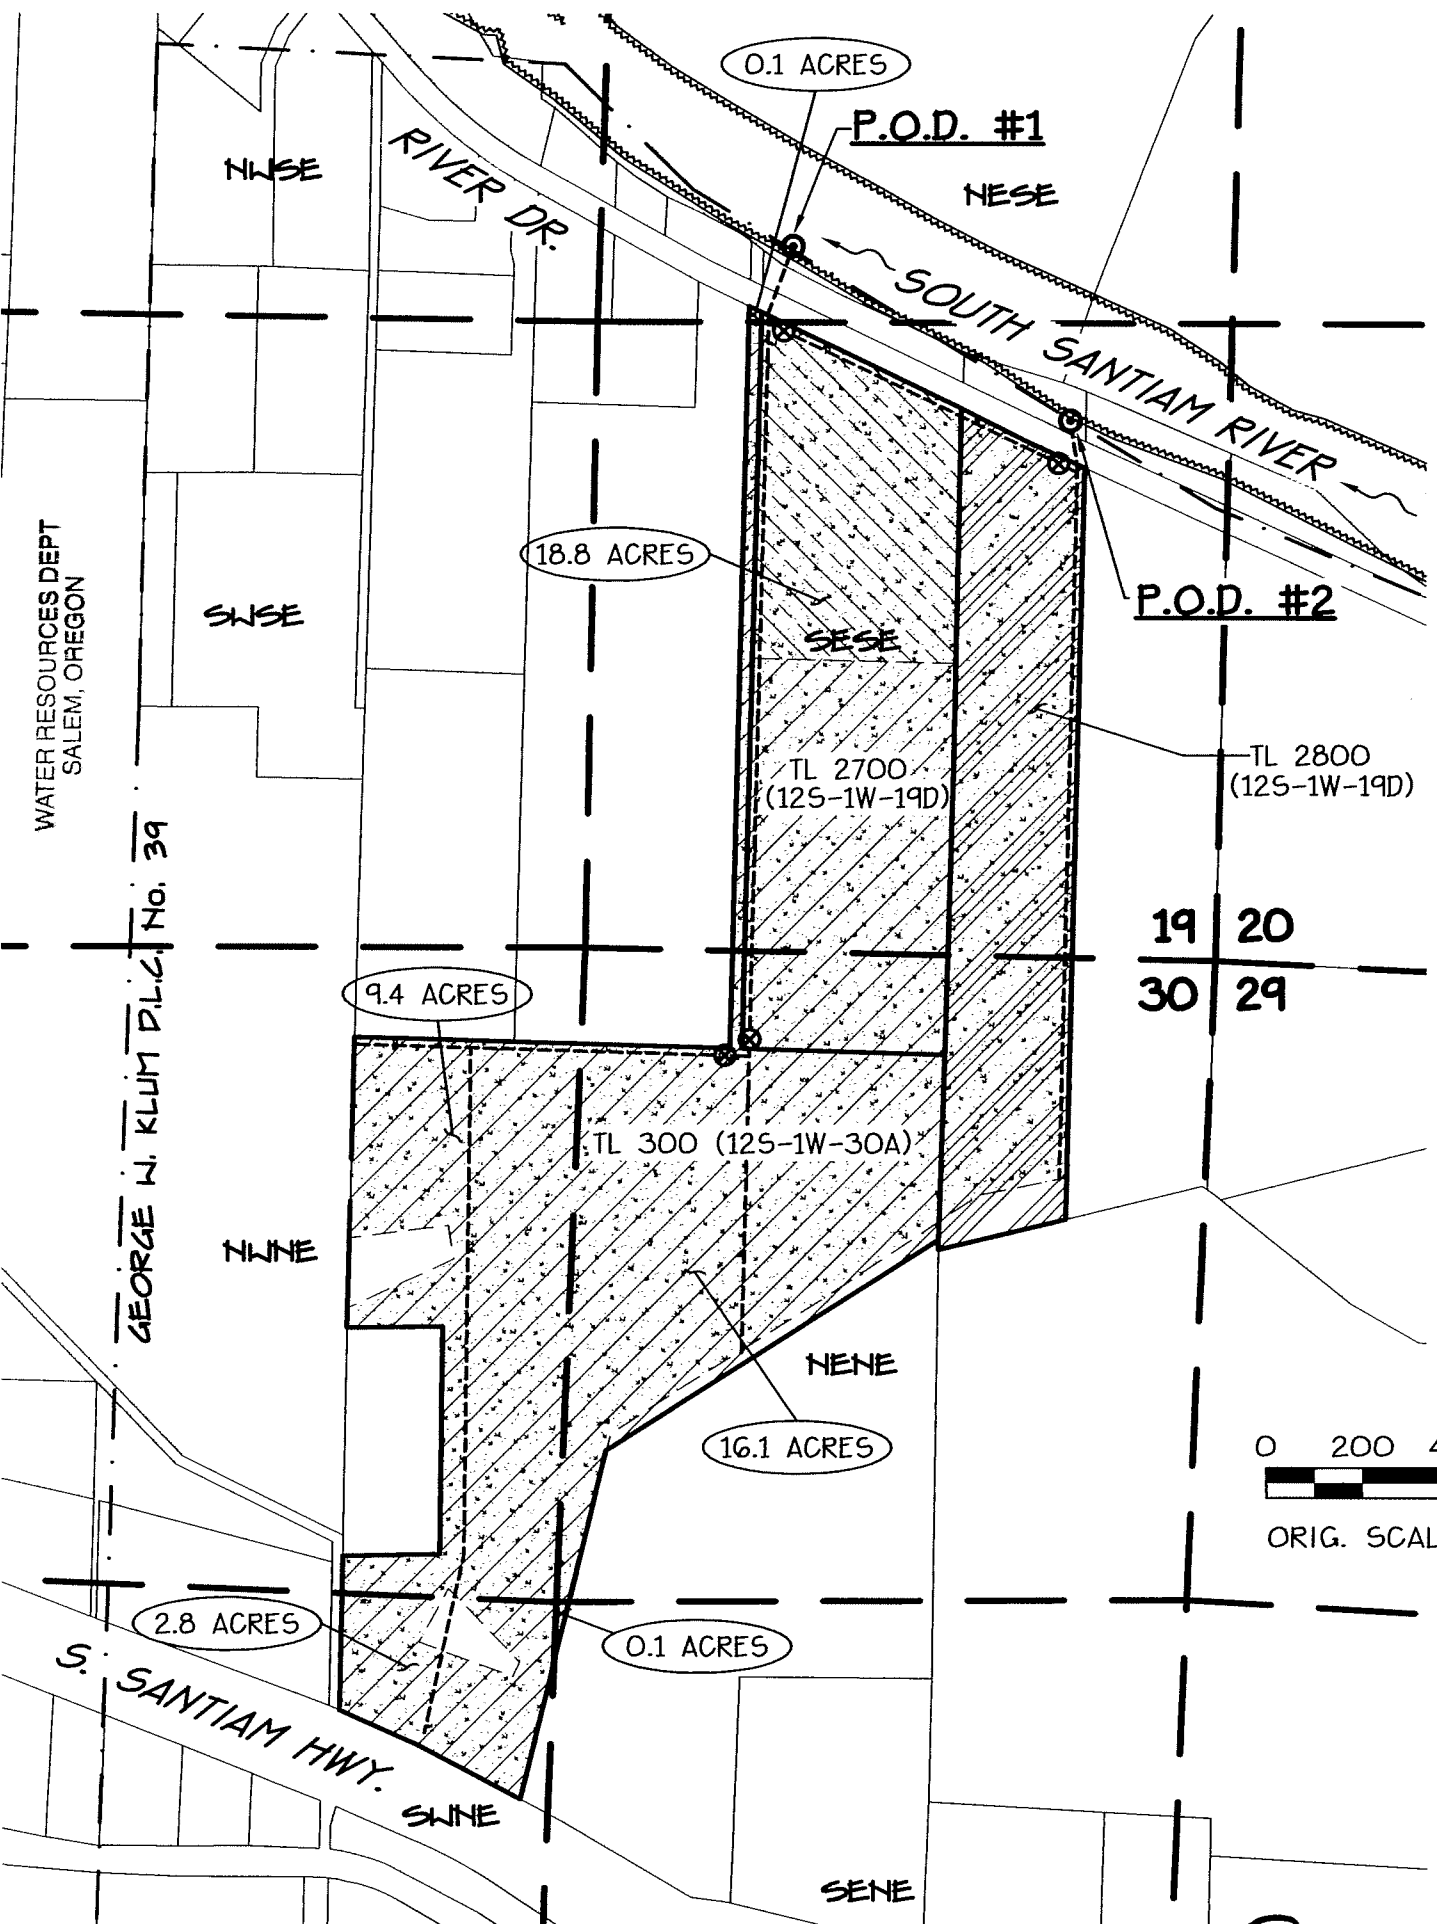







CLAIM OF BENEFICIAL USE MAP
FOR
DAVID AND LEANNE VAN ESSEN



LOCATED IN
GEORGE W. KLUM D.L.C. No. 39
SE 1/4, SEC. 19 + NE 1/4 SEC. 30,
T. 12 S., R. 1 W., W.M.
LINN COUNTY, OREGON

~~NOVEMBER 24, 2015~~
REVISED: FEBRUARY 9, 2016

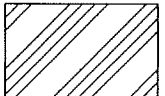APPLICATION: 5-84994
PERMIT: 5-53869

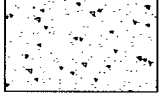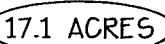LEGEND:

-  CERTIFICATE 30296
USE: IRRIGATION
SOURCE: SOUTH SANTIAM RIVER
AREA: 9.8 ACRES
-  CERTIFICATE 37960
USE: IRRIGATION
SOURCE: SOUTH SANTIAM RIVER
AREA: 31.5 ACRES
-  CERTIFICATE 40567
USE: IRRIGATION
SOURCE: SOUTH SANTIAM RIVER
AREA: 6.0 ACRES
-  AREA IRRIGATED UNDER PERMIT 5-53869, PERFECTED BY THIS CLAIM
USE: NURSERY, OCTOBER 1 - APRIL 30
SOURCE: SOUTH SANTIAM RIVER
AREA: 47.3 ACRES
-  17.1 ACRES
AREA IRRIGATED UNDER PERMIT 5-53869
PER 1/4 1/4 SECTION
-  POINT OF DIVERSION UNDER PERMIT 5-53869 W/ ATTACHED METER
-  WATER VALVE
-  BURIED 4" OR 5" MAINLINE

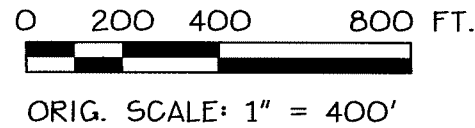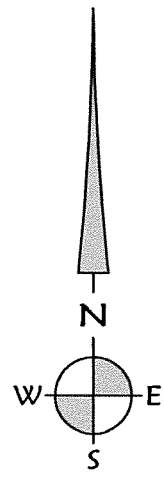

P.O.D. #1

420' SOUTH AND 1,320' EAST
OF NW CORNER OF DLC #39

P.O.D. #2

1,100' NORTH AND 300' WEST
FROM SE CORNER OF SECTION 19

FISH SCREEN NOTE:

THE APPROVED FISH SCREEN IS CONNECTED TO THE INTAKE
AND LOCATED AT THE AUTHORIZED P.O.D.

IRRIGATION NOTE:

MAILINE SHOWN IS BURIED 4" AND 5" LINE, LATERAL LINES ARE
NOT SHOWN ON THIS MAP. LOCATION OF MAINLINE IS BASED
ON SCHEMATICS OF THE SYSTEM.

NOTE:

THIS MAP IS NOT INTENDED TO PROVIDE LEGAL DIMENSIONS OR
LOCATION OF PROPERTY OWNERSHIP. INFORMATION ON THIS MAP IS
COMPILED FROM 2014 LINN COUNTY GIS DATA, AERIAL PHOTOGRAPHY
AND OTHER RECORD SURVEY INFORMATION.



K & D ENGINEERING, Inc.
276 N.W. Hickory Street P.O. Box 725
Albany, Oregon 97321
(541) 928-2583

Date: 2/9/2016 Time: 9:42
Scale: 1=400(PS)
File: dwg\2004\04-50\0450-claim53869.dwg (lan)

956