



T16S, R12W., W.M.
SECTION 3 & 10
LANE COUNTY, OREGON
Tax Lot 800 Assessor Map 16-12-10

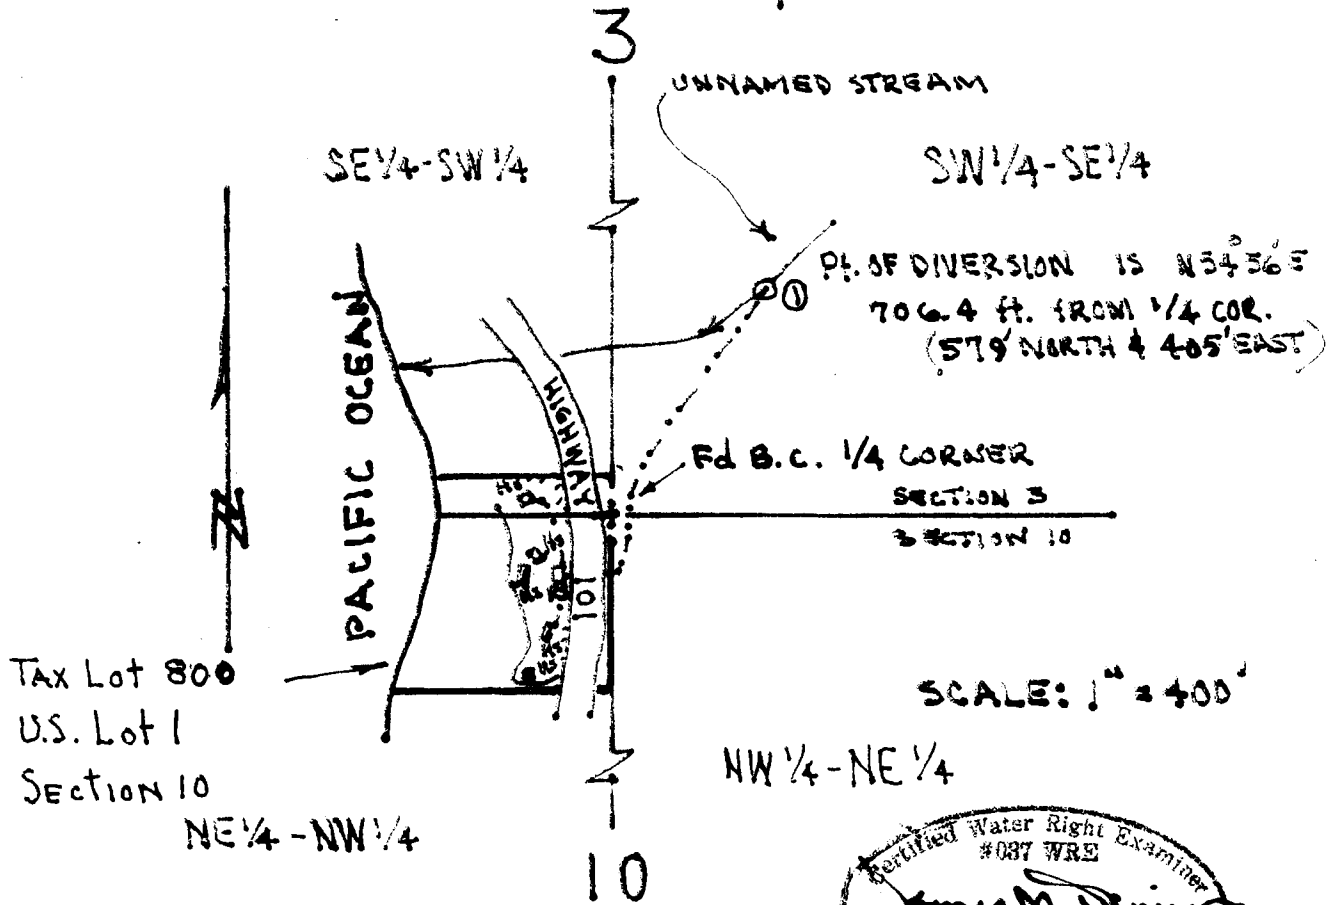

RECEIVED
SEP 24 2007
LAND DIVISION
STATE OF OREGON

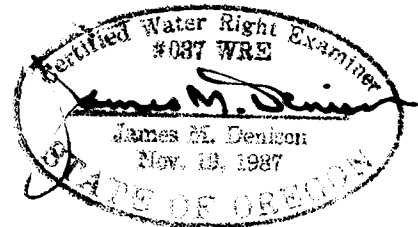

**TRANSFER SURVEY
UNDER**

PERMIT # 23948 T-9429 **SPECIAL ORDER** Volume 58 page 47

**IN THE NAME OF
MELITA MARSHALL
The Oregon House**

SURVEYED: AUGUST 24, 2007

BY: James M. Denison

THIS MAP PREPARED SOLEY FOR THE PURPOSE OF SHOWING LOCATION OF A WATER RIGHT, AND IS NOT INTENDED FOR USE TO PROVIDE DIMENSIONS OR LOCATION OF PROPERTY OWNERSHIP LINES.

Final Proof Map