


T. 39S., R. 35 & 36E., W. M.

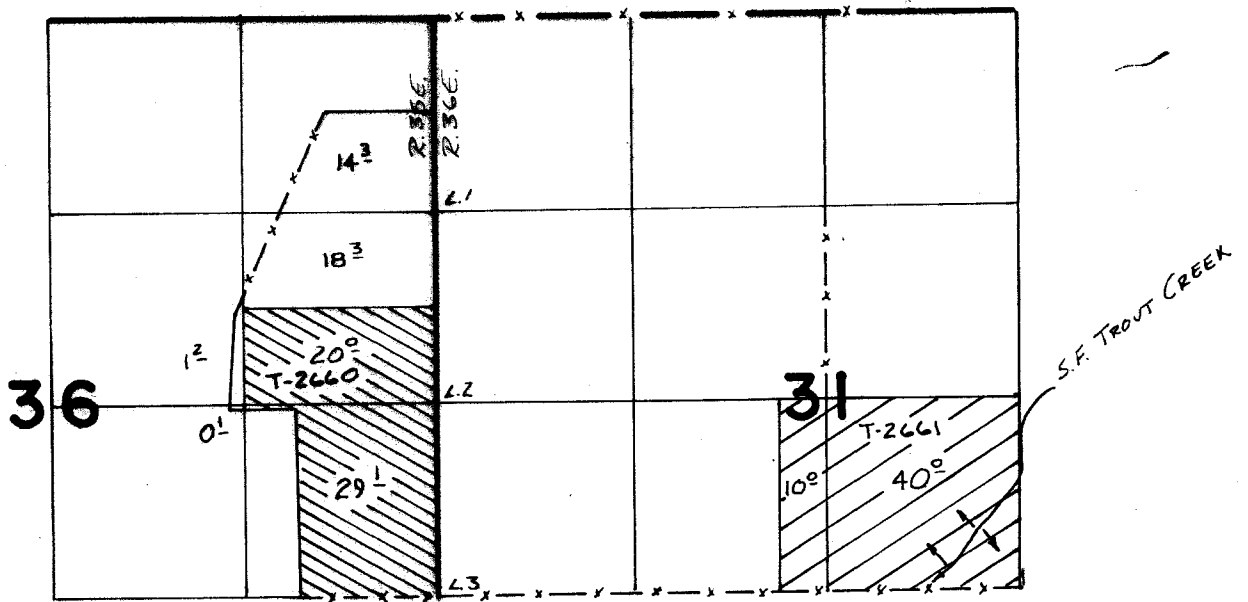

Scale 1" = 1320'

**FINAL PROOF SURVEY**  
UNDER

**TRANSFERS 2660, 2661**  
IN NAME OF

**HUMBOLT LAND & LIVESTOCK CO.**

Surveyed ...7-15... 1933, by V. L. Church.....