


T. 39S., R. 35 & 36E., W. M.

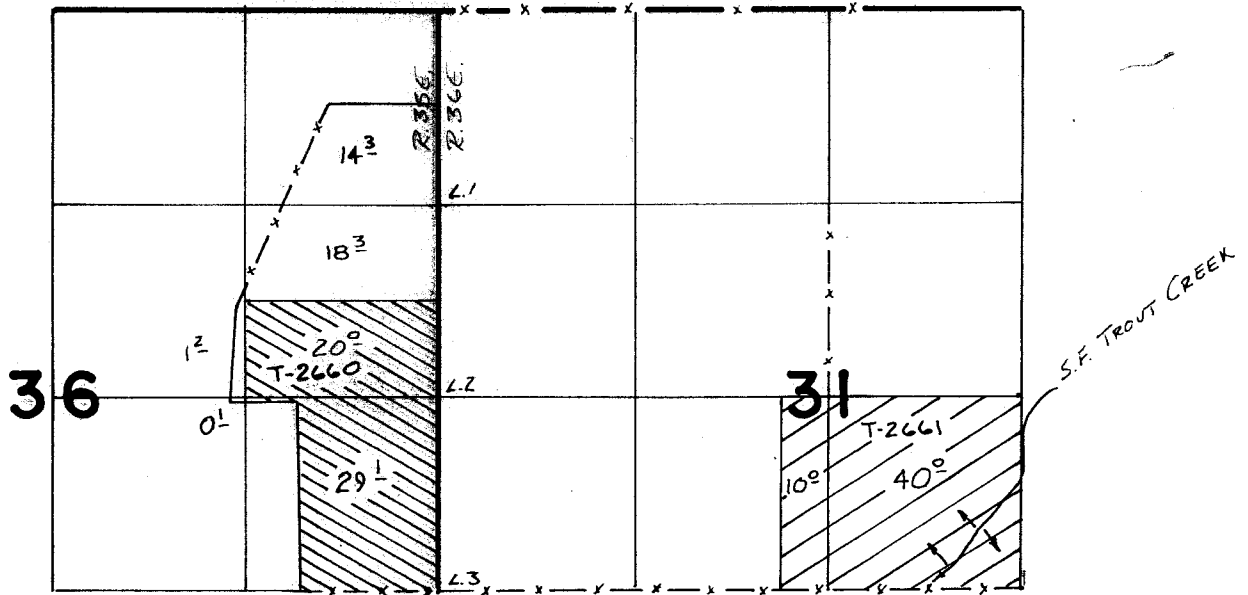

Scale 1" = 1320'

FINAL PROOF SURVEY

UNDER

TRANSFERS 2660, 2661

IN NAME OF

HUMBOLT LAND & LIVESTOCK CO.

Surveyed 7-15-1988, by V. L. Church