

CLAIM OF BENEFICIAL USE MAP
FOR
PERMIT TO STORE WATER
SWEET HOME COMMUNITY CHAPEL
LOCATED IN
SW 1/4 NE 1/4 SEC. 5, T. 14 S., R. 1 E., W.M.,
LINN COUNTY, OREGON

AUGUST 17, 2010

APPLICATION FILE No. R-79607
PERMIT No. R-12084

PERMITTEE:

COMMUNITY CHAPEL CHURCH

OWNER:

SWEET HOME COMMUNITY CHAPEL CHURCH

ADDRESS:

42250 AMES CREEK RD.
SWEET HOME, OR 97386


TAX LOT:

800 (MAP 14-1E-5)

RECEIVED

AUG 27 2010




WATER RESOURCES DEPT
SWEET HOME, OREGON

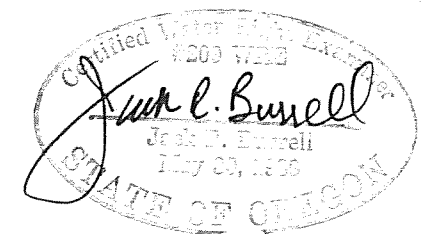

RENEWAL DATE 12/31/11

DISCLAIMER:

THIS MAP IS NOT INTENDED TO PROVIDE LEGAL
DIMENSIONS OF PROPERTY OWNERSHIP LINES.

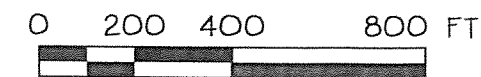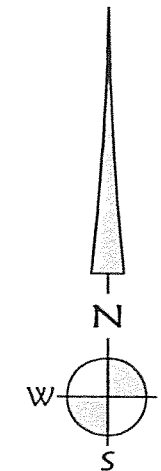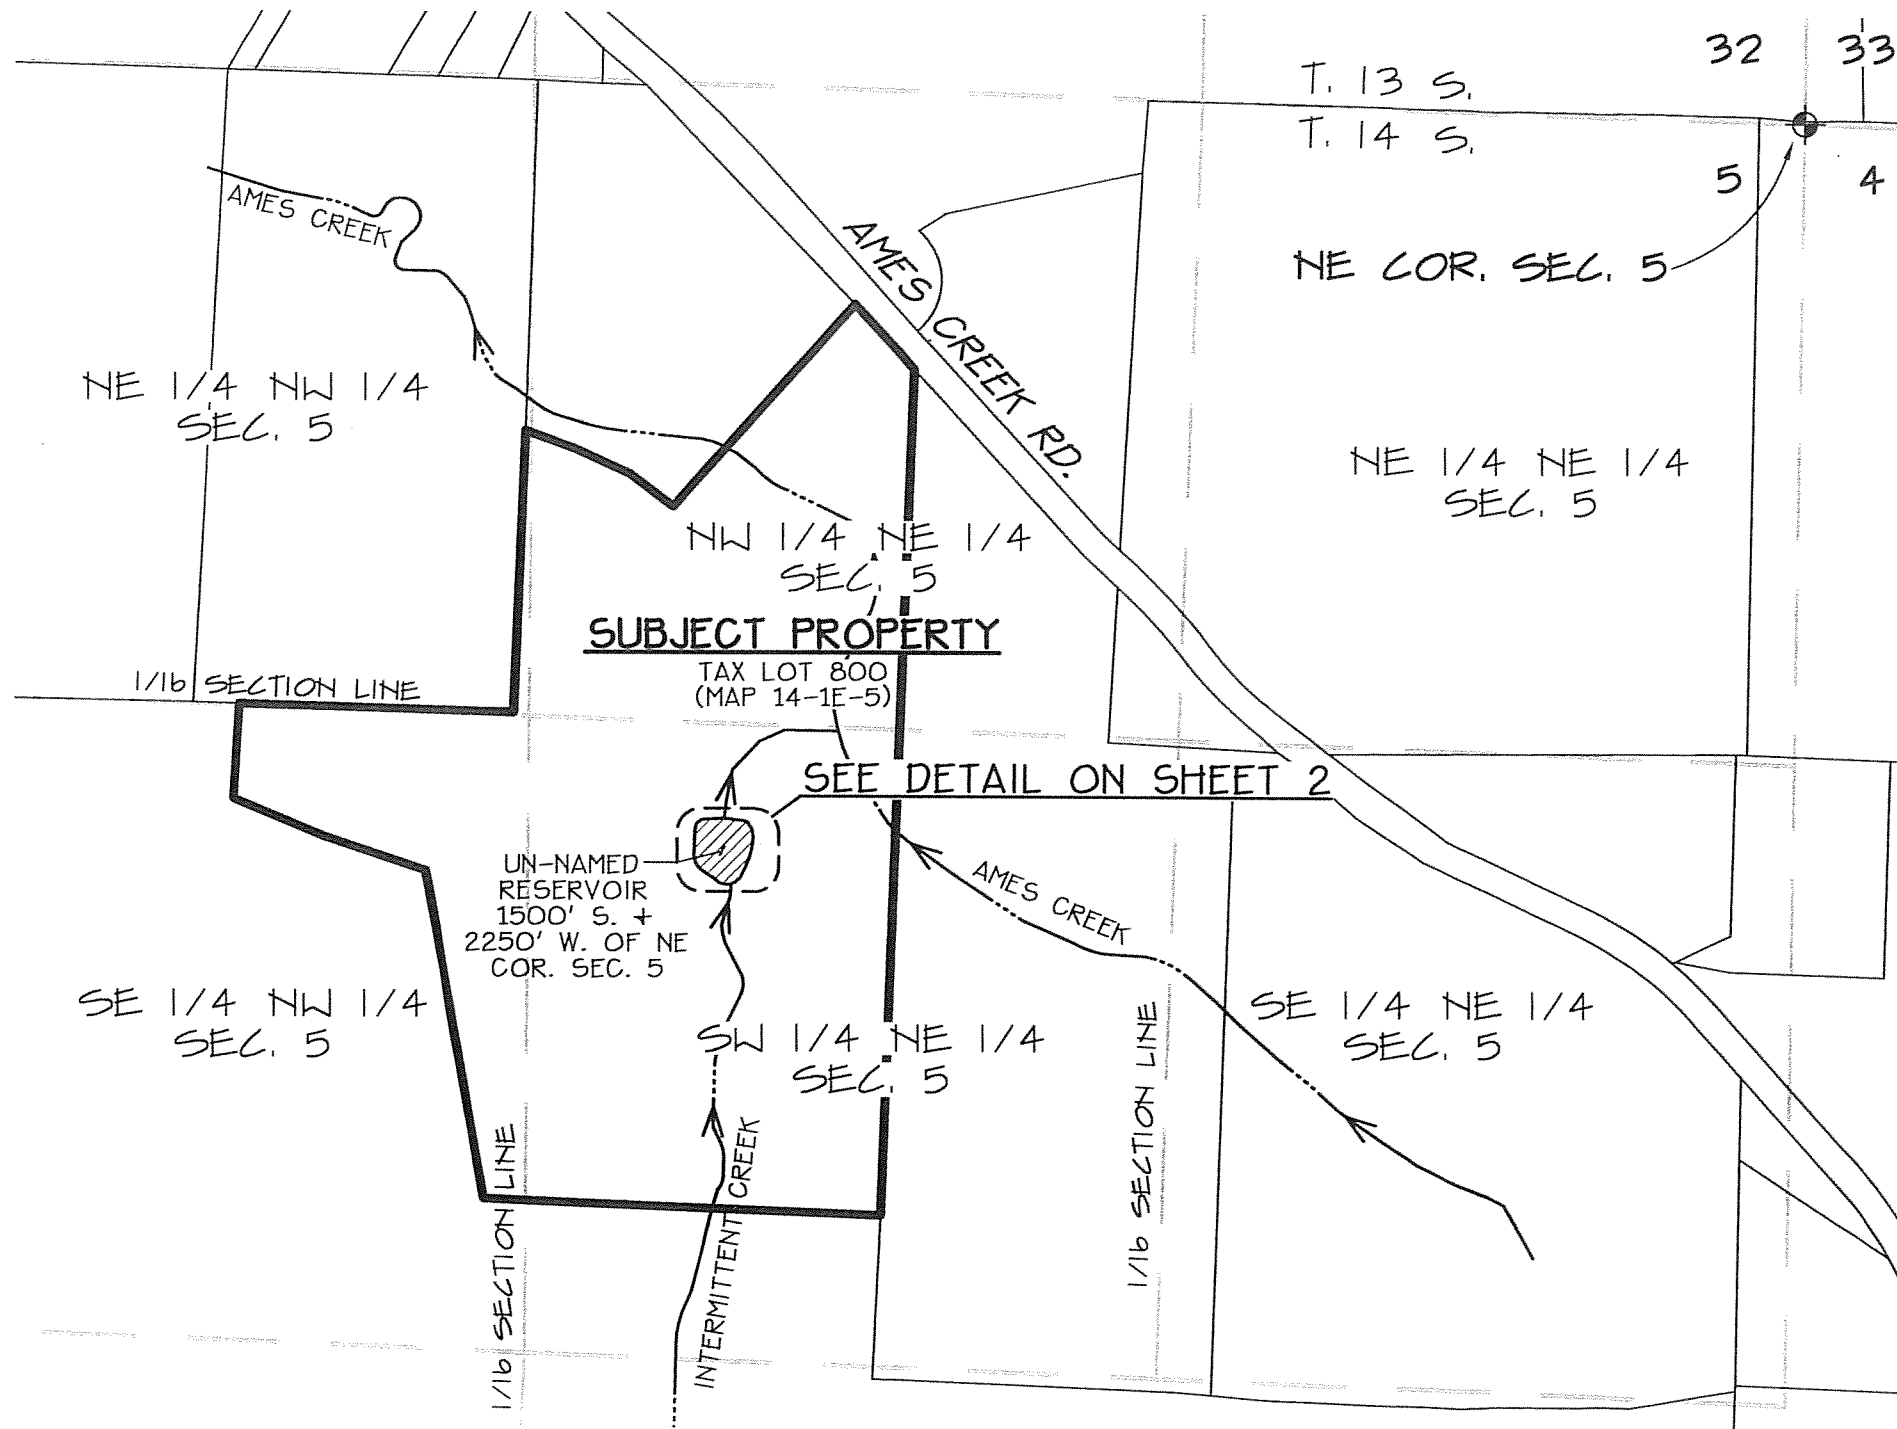

SCALE: 1" = 400'

K & D

K & D ENGINEERING, Inc.
278 N.W. Hickory Street P.O. Box 725
Albany, Oregon 97321
(541) 928-2583

Date: 8/18/2010

Time: 9:19

Scale: 1=400(PS)

File: dwg\2010\10-110\10-110aerial.dwg (lan)

SHEET 1 OF 2