






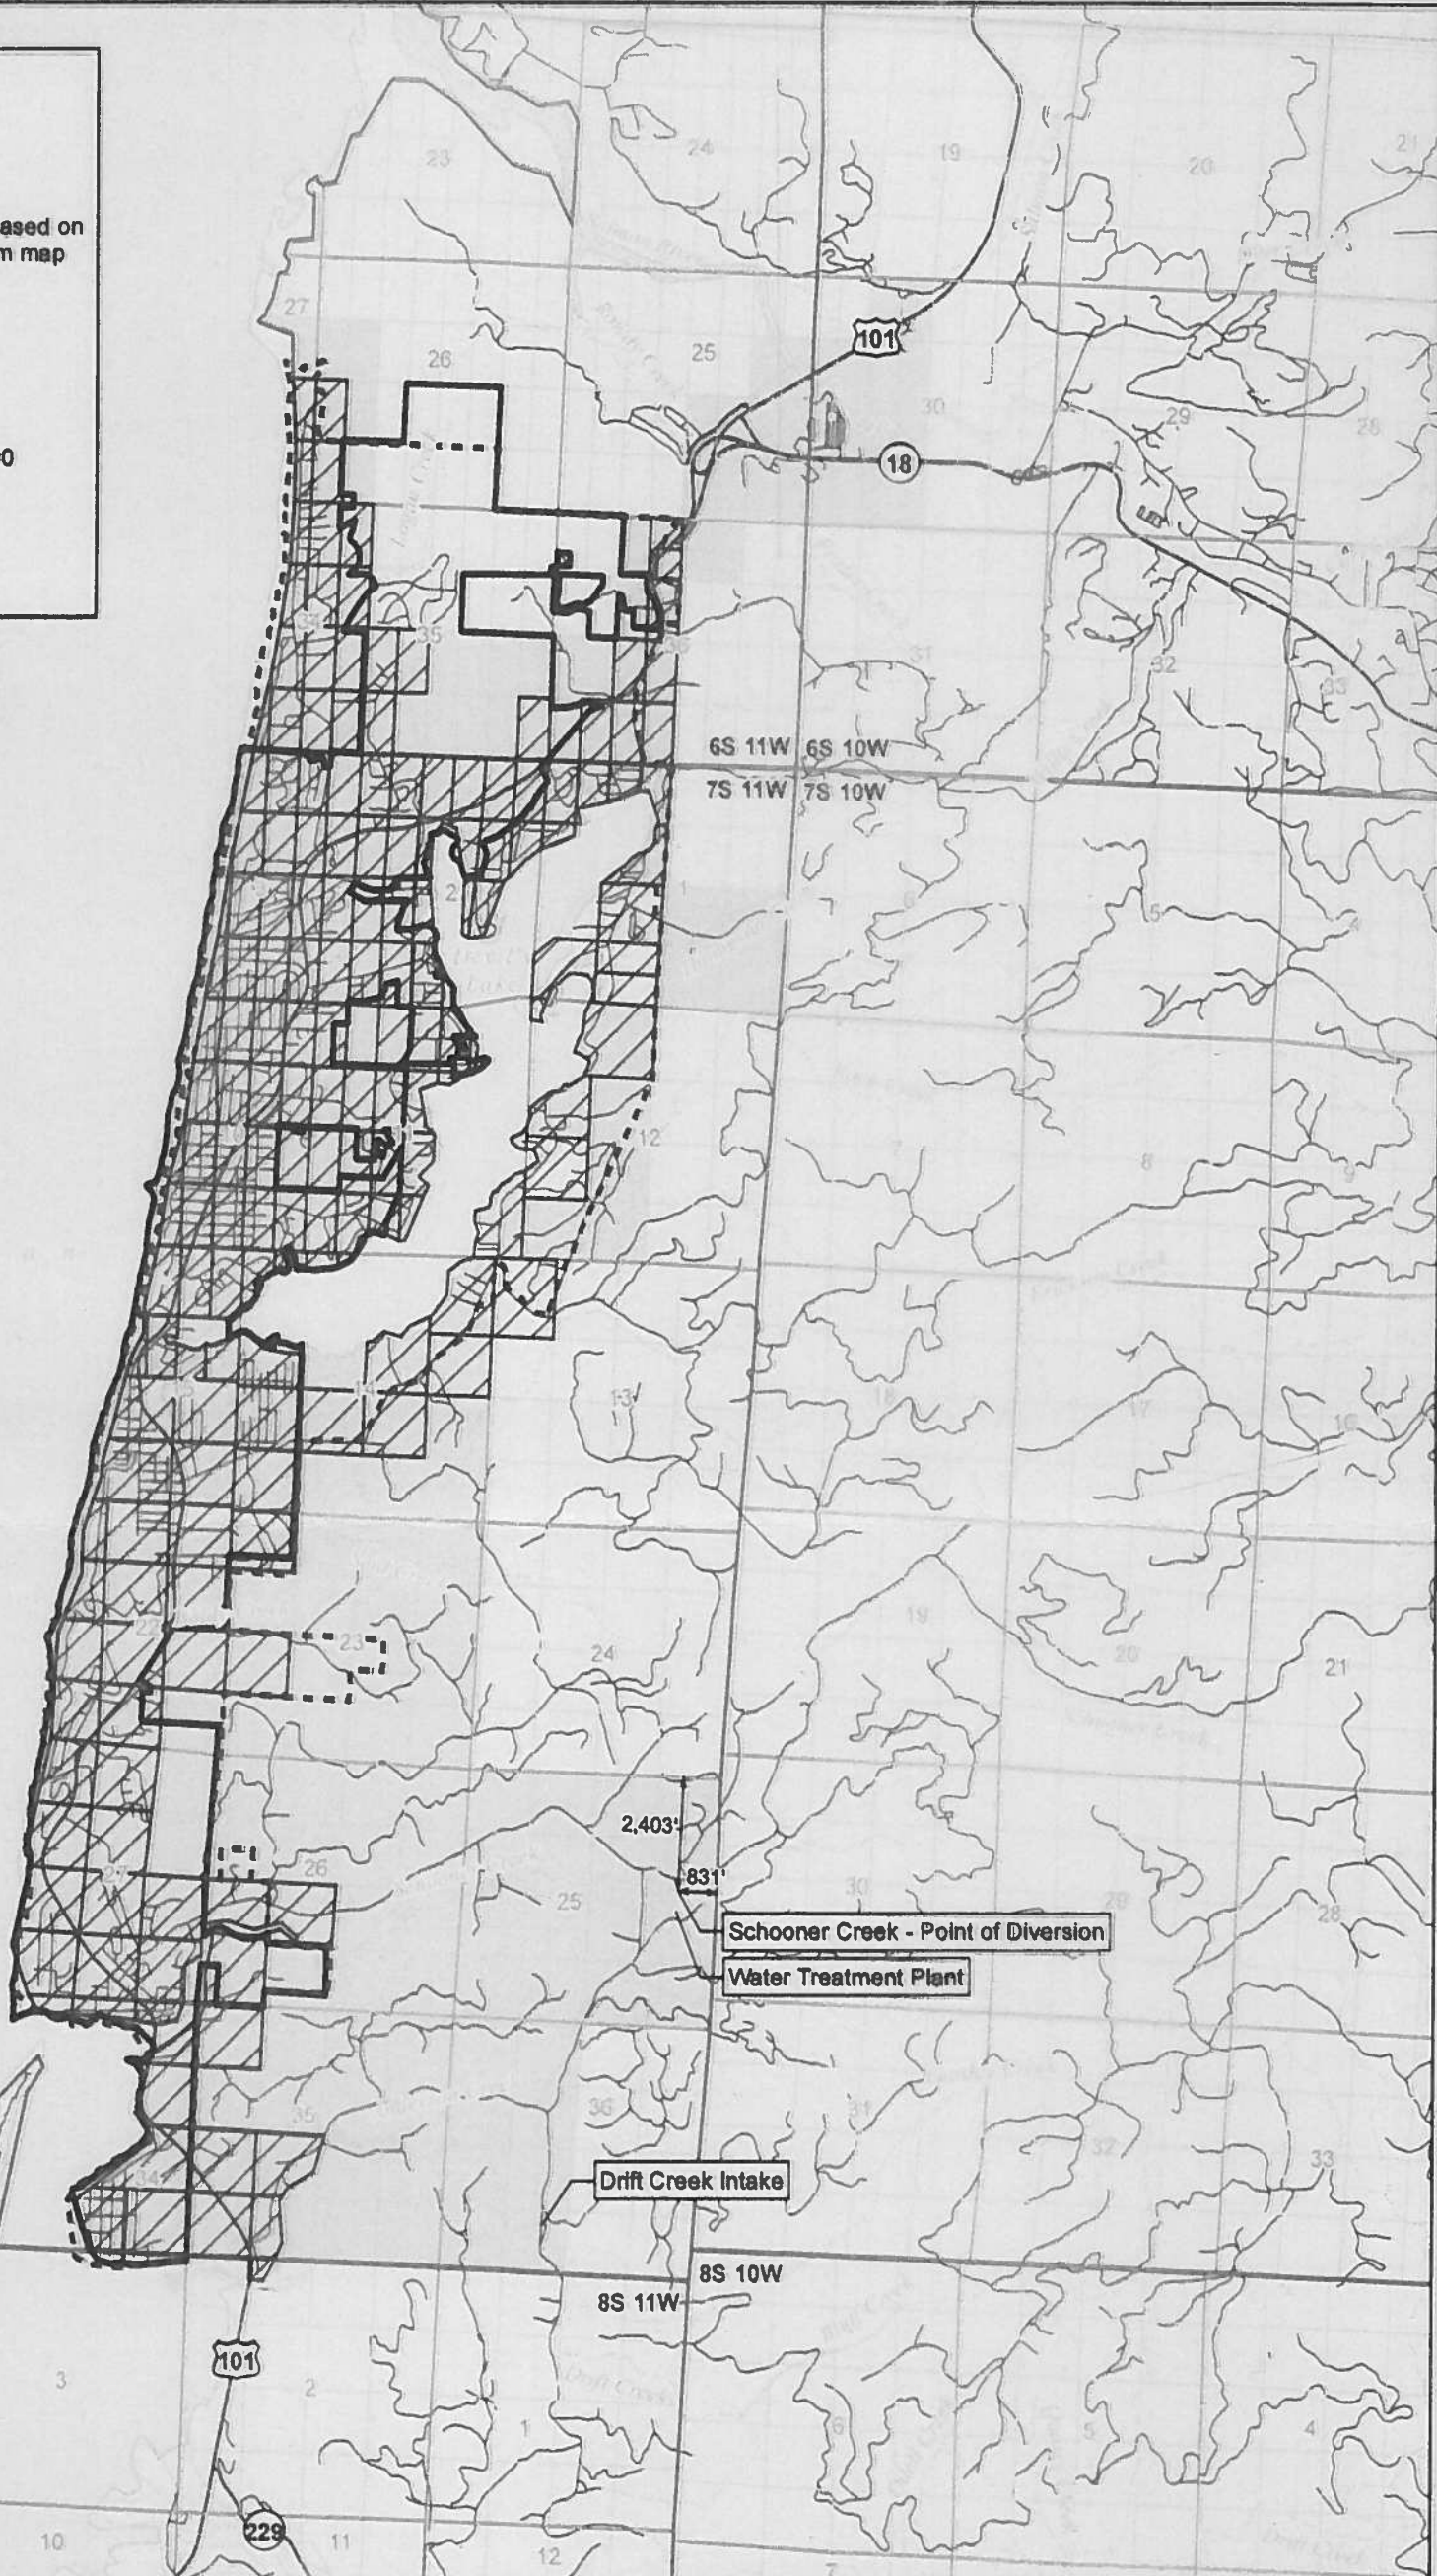


LEGEND:

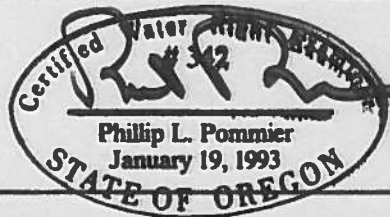
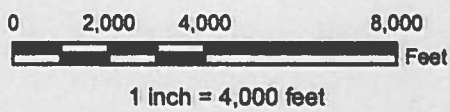
- Highway
- Stream
-  Place of Use, October 1999 based on the originally submitted system map
-  Area of Use Authorized by Permit S-37605
- Street Centerline
-  City Limits - 1999
-  Urban Growth Boundary - 2000
-  Township & Range
-  Section
-  1/4 Section or 1/8 Section



Note:
Refer to originally submitted system map for detail concerning place of use.



RECEIVED BY OWRD
SEP 08 2014
SALEM, OR

Disclaimer: The purpose of the map is to identify the location of the water right. It is not intended to provide information relative to the location of property ownership lines.



 CITY OF LINCOLN CITY	CLIENT:	DWN BY: SD	PROJECT: LINCOLN CITY CLAIM OF BENEFICIAL USE	REV. NO.:
	 AMEC 7376 SW Durham Road Portland, OR, U.S.A. 97224	PROJECTION: NAD83 HARN OR SP N. Int. FL SCALE: 1 inch = 4,000 feet	TITLE: POINT OF DIVERSION & PLACE OF USE MAP FOR PERMIT S-37605	DATE: JULY 2014 PROJECT NO.: 4-81M-12999-0 FIGURE NO.: S-37605