T. 16 S. R. 5 W. W. M. SEC.S. 31 & 32
T. 17 S. R. 5 W. W. M. SEC.S. 5 & 6
LANE COUNTY, OREGON

FINAL PROOF SURVEY (MAP 1)

IN NAME OF
DWYANE & BARBARA BUSH
UNDER APPLICATION NO. S-73414 PERMIT NO. 53294

MODIFIED BY OWRD 1-8-16 LFB

*FOR PRIMARY AND SUPPLEMENTAL PLACE OF USE DESIGNATION SEE MAP 2

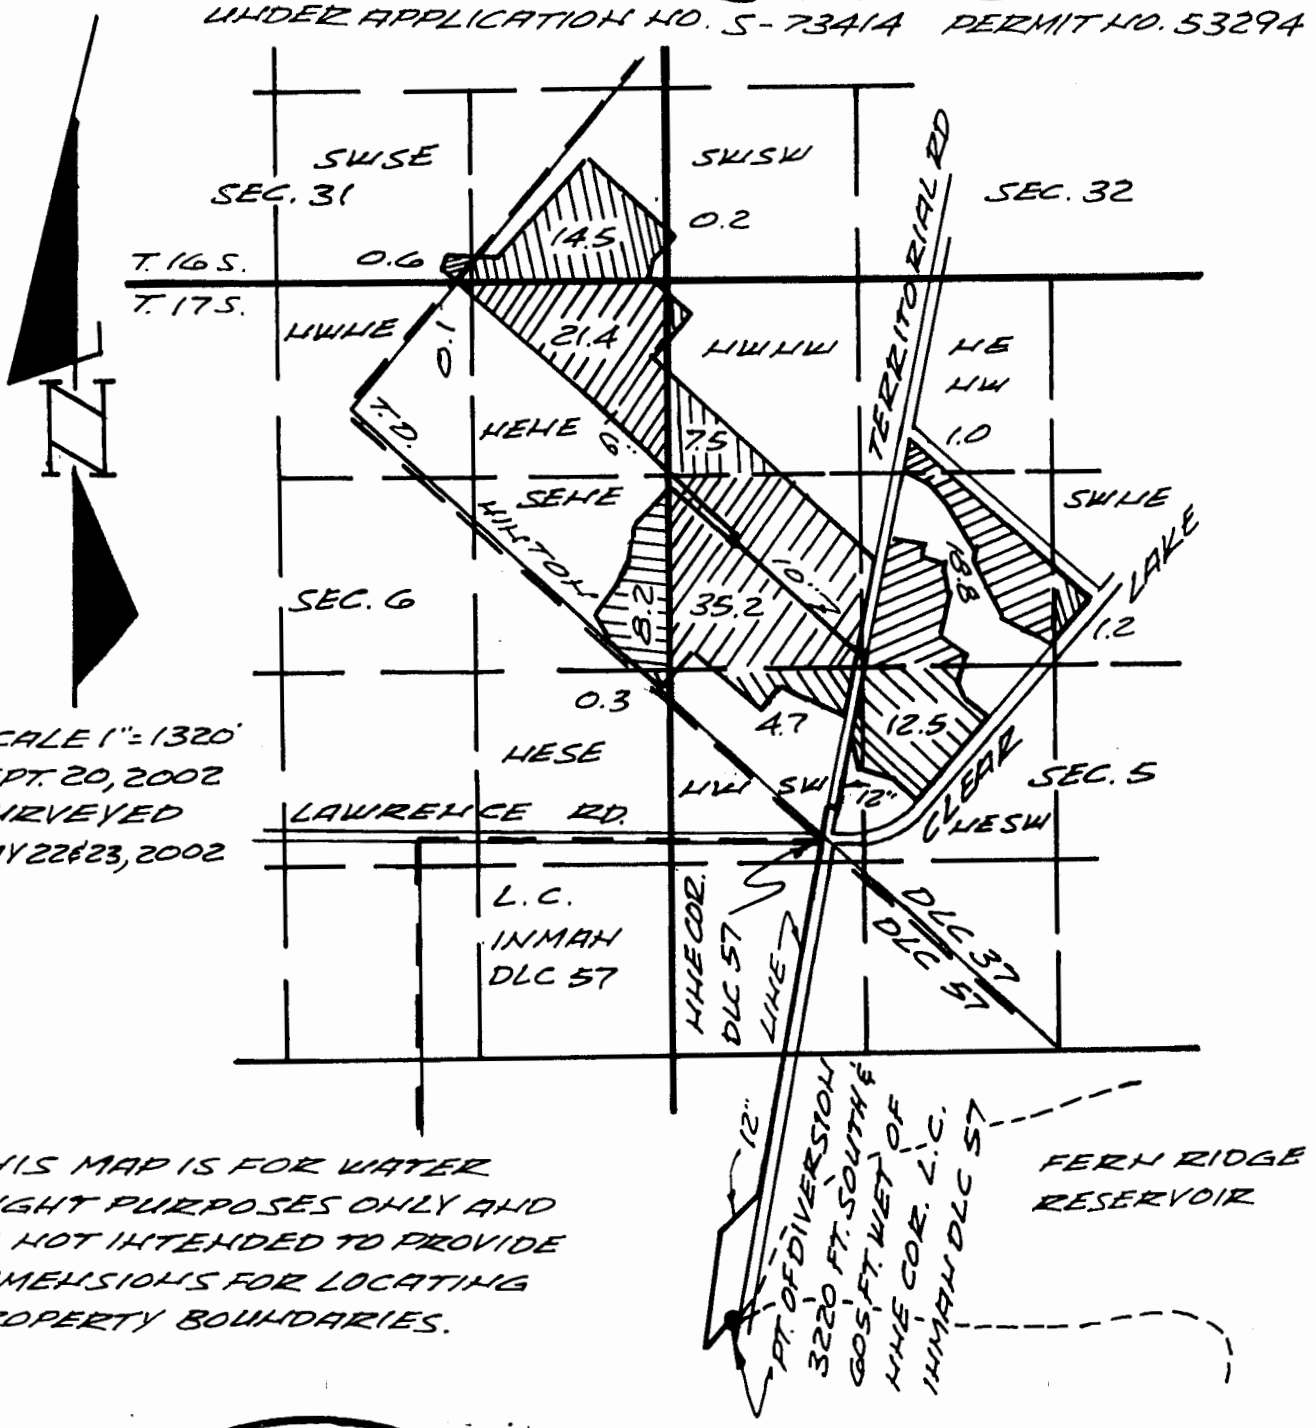

SCALE 1" = 1320'
SEPT. 20, 2002
SURVEYED
MAY 22 & 23, 2002

THIS MAP IS FOR WATER RIGHT PURPOSES ONLY AND IS NOT INTENDED TO PROVIDE DIMENSIONS FOR LOCATING PROPERTY BOUNDARIES.

Certified Water Right Examiner
#166
Charles W. Guile
Charles W Guile
May 17, 1988
STATE OF OREGON
6/30/2003

RECEIVED
OCT 0 4 2002
WATER RESOURCES DEPT.
SALEM, OREGON

CHARLES W. GUILE
& ASSOCIATES, CO.
Land Surveying
82 Centennial Loop
Eugene, OR 97401

93-26

(MAP 2)

Application S-73414 Permit S-53294

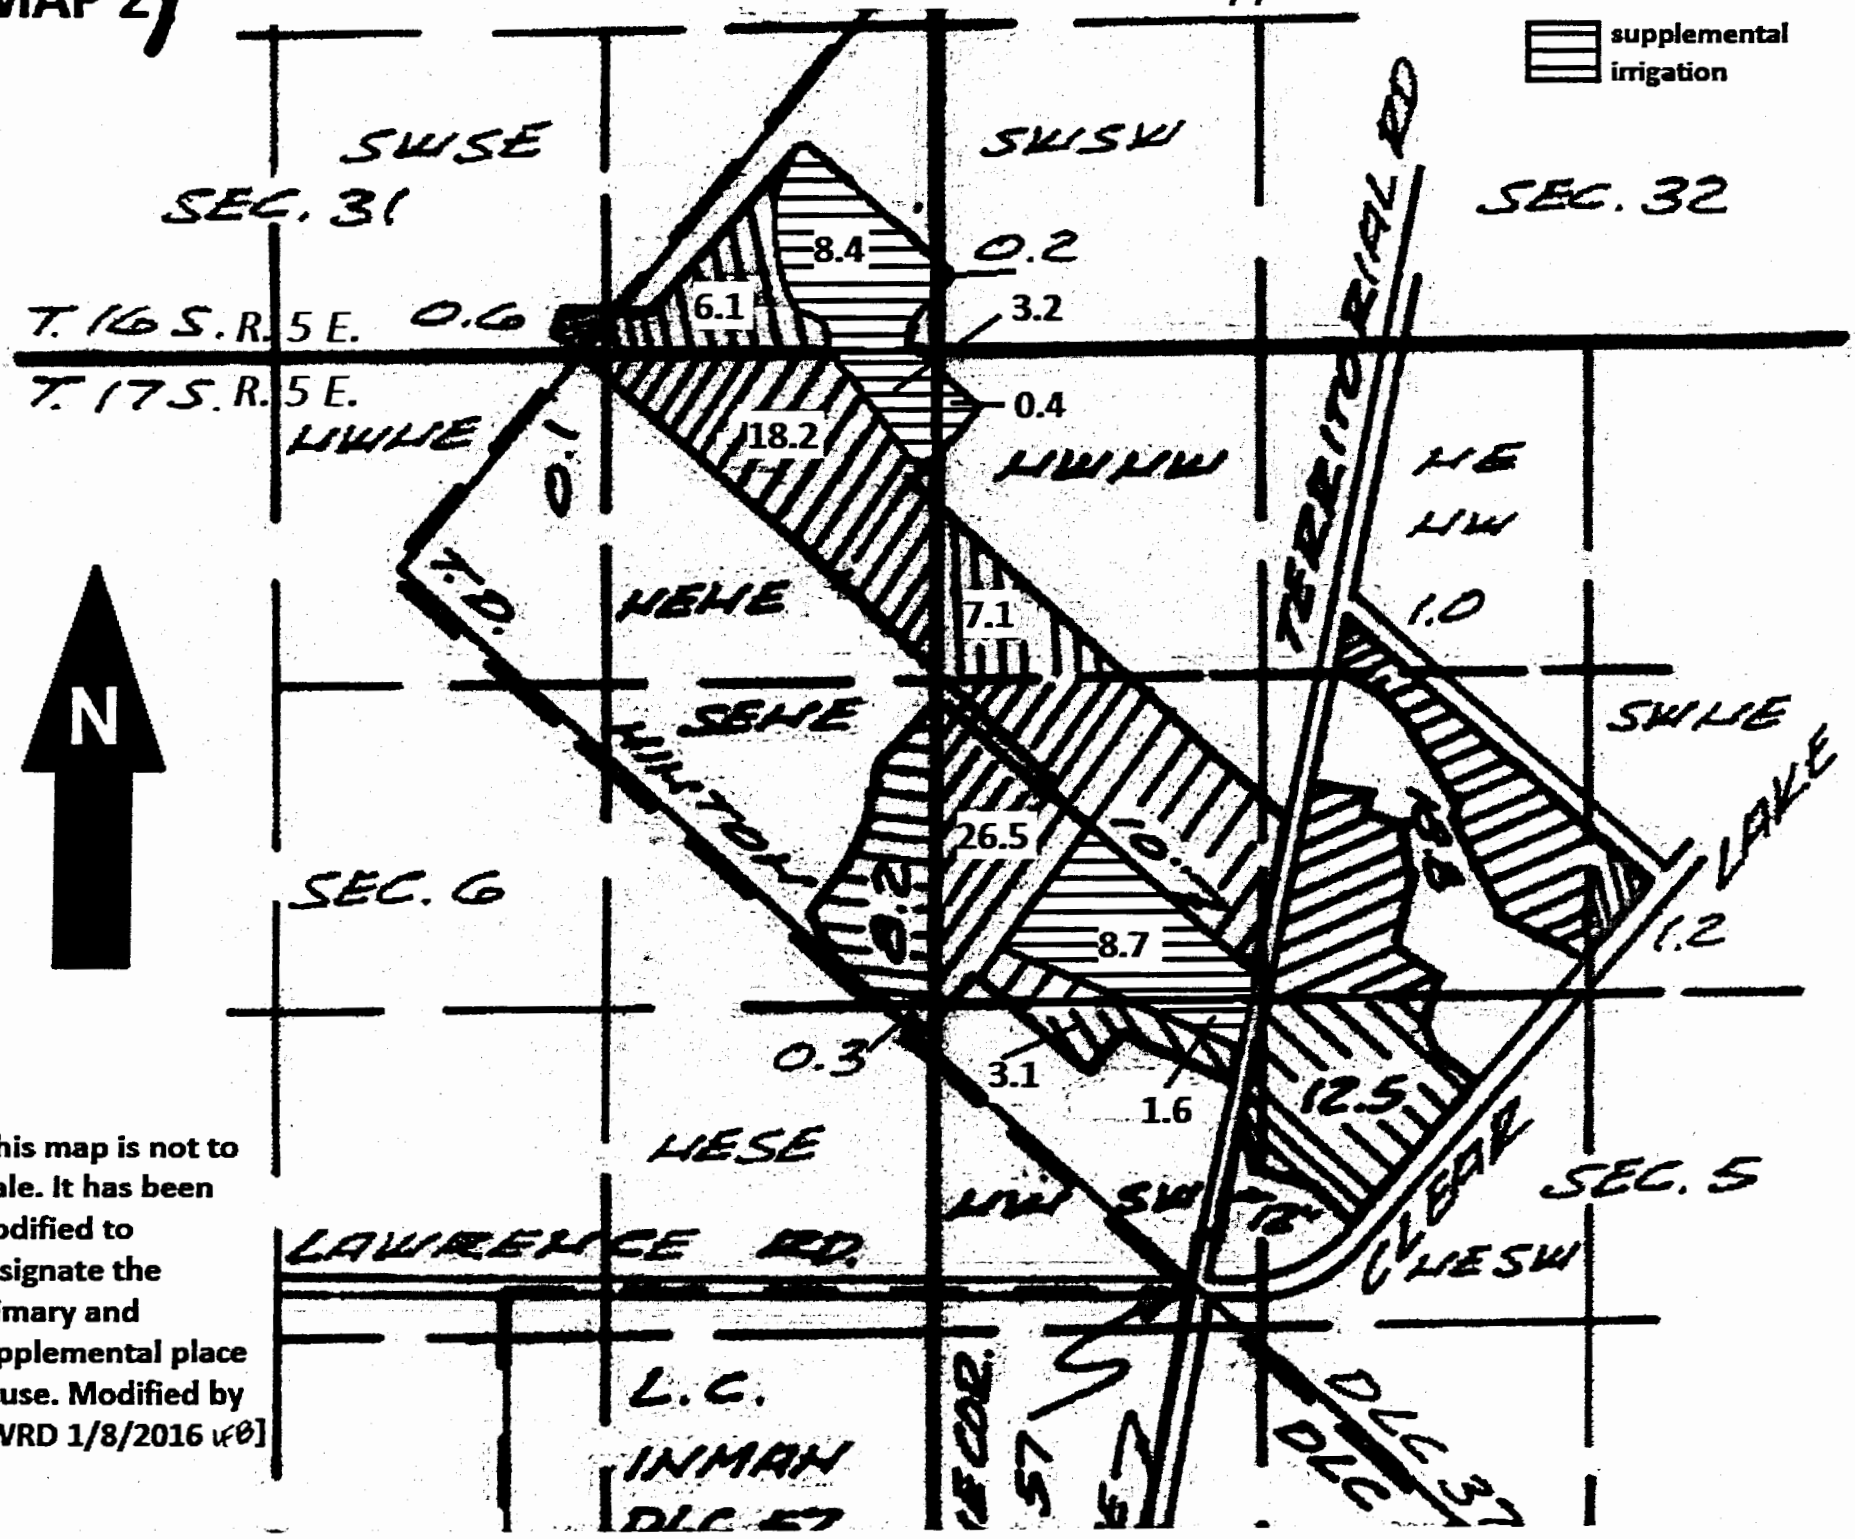

[This map is not to scale. It has been modified to designate the primary and supplemental place of use. Modified by OWRD 1/8/2016 vf0]