

CLAIM OF BENEFICIAL USE MAP

PAUL J. JAROMSCAK

TRANSFER No. 9144



TOWNSHIP 37 SOUTH, RANGE 6 WEST, SECTION 6, W.M.

MAP 37-06-06-00 T.L. 500

ADDRESS: 3980 HELMS RD.

GRANTS PASS, OREGON 97527

THIS MAP IS FOR THE PURPOSE OF IDENTIFYING THE LOCATION OF THE WATER RIGHT ONLY, AND IS NOT INTENDED TO PROVIDE LEGAL DIMENSIONS OR LOCATIONS OF PROPERTY OWNERSHIP LINES.

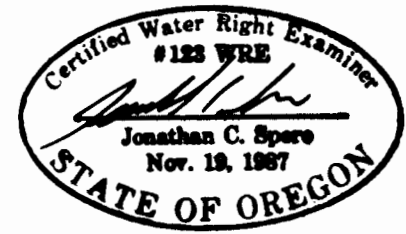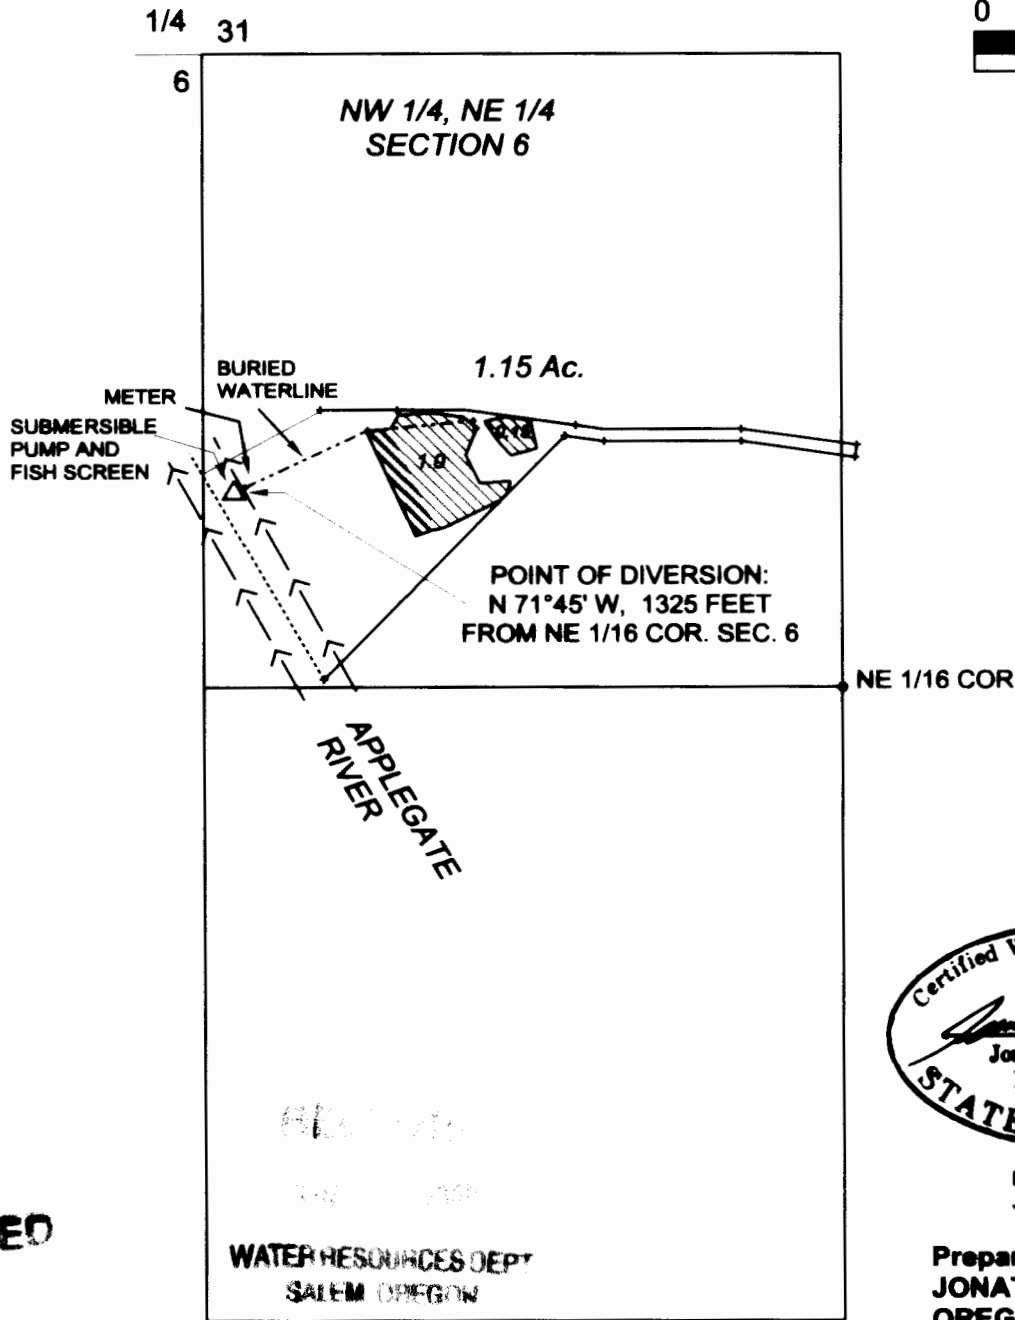

RENEWAL DATE:
JUNE 30, 2010

Prepared By:
JONATHAN C. SPERO
OREGON R.L.S. #2309
P.O. BOX 16
WILLIAMS OR 97544
Ph. (541) 846-6845

FORMER POINT OF DIVERSION:
JESS DITCH 780' N & 800' E
FROM SW CORNER, SECTION 5
(T.37 S. R.6 W. W.M.)

INSPECTION JUNE 10, 2008
MAP PREPARED: JUNE 26, 2008